
NE cor SEC. 8-103-14

Note: Jerry Schwarz #13810 that he set corner based on occupation and that Survey Consultants had used same corner.

JHS CREW dug with RAY TUCKER BACKHOE
AT POINT 1320' south of 1/16th LINE WEST of SEC. 5-103-14
UNCOVERED 3/4" pipe 4" ± Long with CAP No. 13810
REMOVED pipe AND CONTINUED Digging FOUND CLAY SOIL @ 1.0' DEEP, NO EVIDENCE other PLS CORNER.
CORNER WOULD HAVE BEEN destroyed AT time of Road Const.
SET 7/8" ø IN PLACE of 4" pipe. (TEMP)

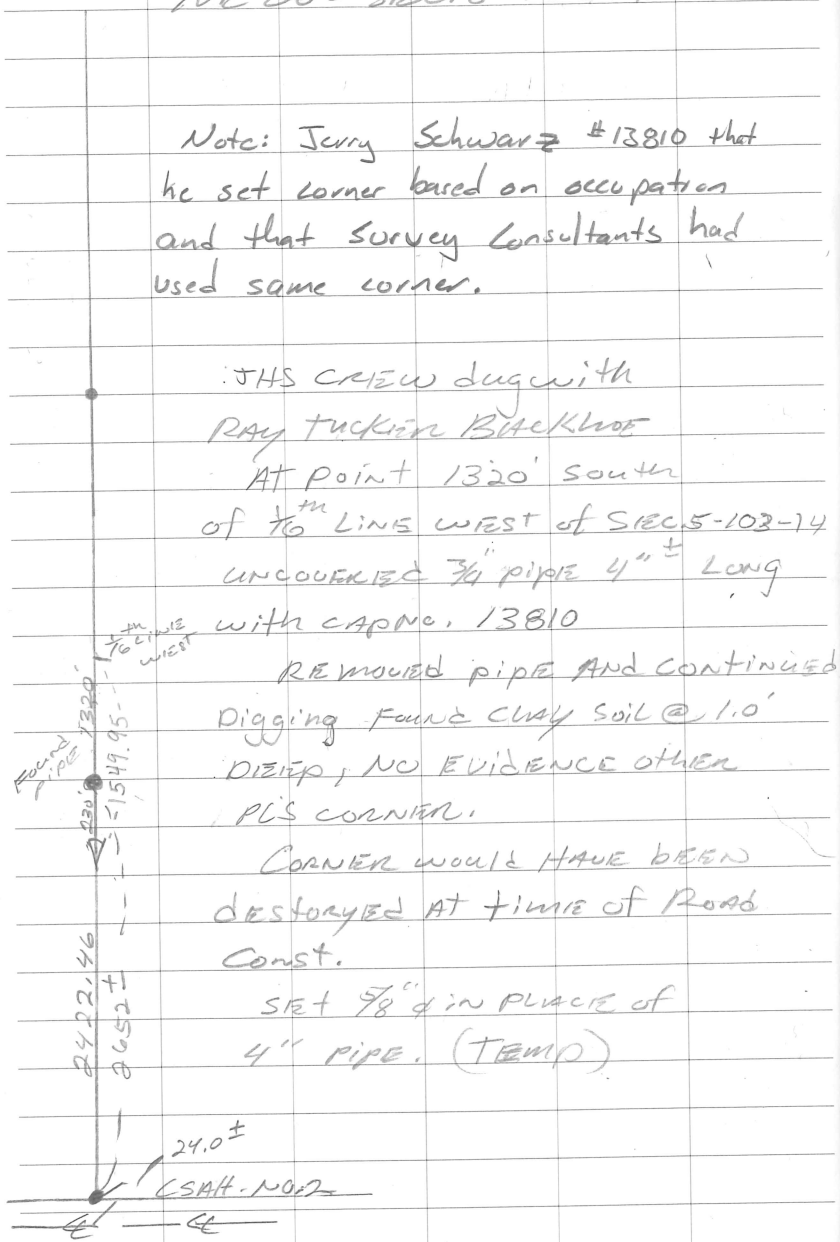

8-1-06 HLS
CLOUDY MOH
80°

