
E ¼ COR Sec. 9-103-14

8-16-06 JHS Found PK NAIL Above Alum Mon. Shot with GPS For BaseMap

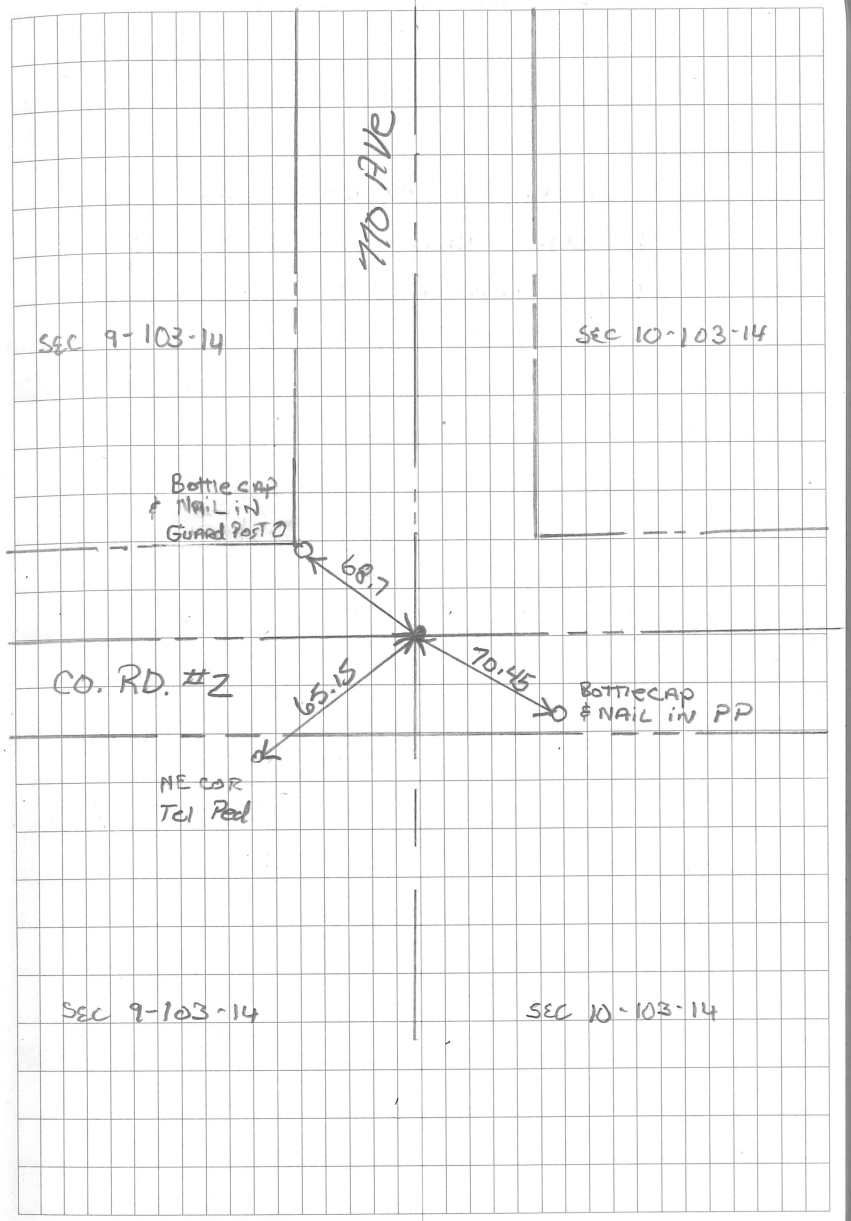



W¼ cor SEC. 8-103-14

E¼ cor SEC. 8-103-14

SIZE Co. Rd. PLAN.

To POC

BS W¼ cor. SEC 7

D 1131.76

FS PI @ STA 50+15.5

Δ 3883.66

FS W¼ cor @ STA. 54+30.06

Δ 180°00'00' 4298.76

/ W

To PI. @ STA. 80+64.0

BS W¼ cor. @ STA. 54+30.6

R 2633.40

FS E¼ cor @ 107+06.8

D 180°00'00' 2642.80

/ W

P cone NAIL

PK CIM

DRILL HOLE

P 7/8"

P cone NAIL

10-16-02
CLOUDY

HLS
ERB

63

