
E¼ Cor Sec 12-103-14

Cert. Filed 11-11-91 by JHS

Dug with Co. backhoe at a position using ties from new grading project to pipe and tin inplace. Testimony of Co. Employees Ray Tucker RLS# dug corner with backhoe before grading project. a 24" RCP was installed at this position and destroyed CIM and any other perpetuation of the orginal PLS corner using Co. ties est. during grading project placed a CIM at same Location

8-14-6 JHS CREW FOUND SPINDLE AT ROADSURFACE TIES FIT WELL. SHOT FOR BASEMAP

8-29-91 DRR 6.

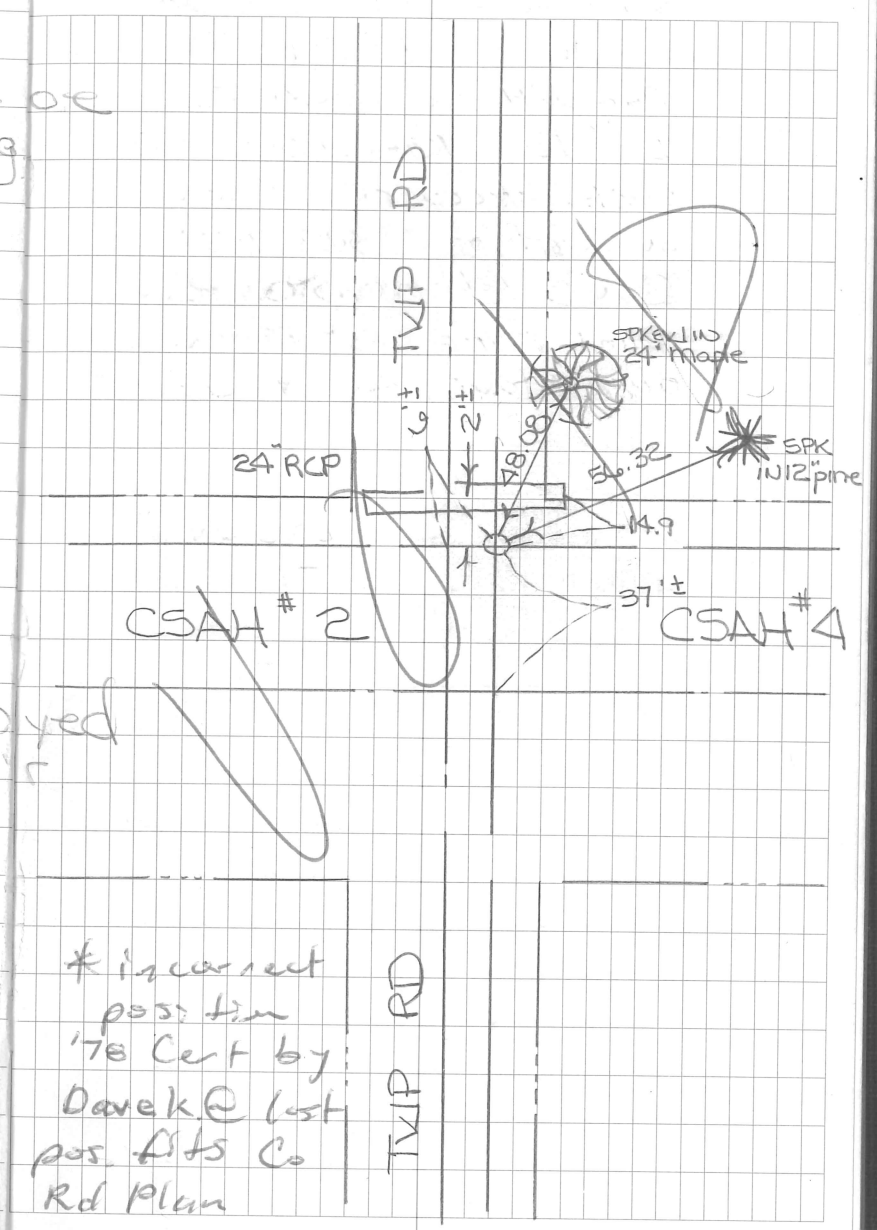

* incorrect position Cert by Dave K @ last pos of Co Rd plan