
10-1-02
80°

CPV
GKB

S1/4 Cor Sec 17-103-14

JHS Crew Searched area and Found No Evidence of original PLS Cor.

Computed Position of Cor by doubling the distances of the 1/16 ±1 Fences from the East and West and on a straight line between the SE & SW Corners

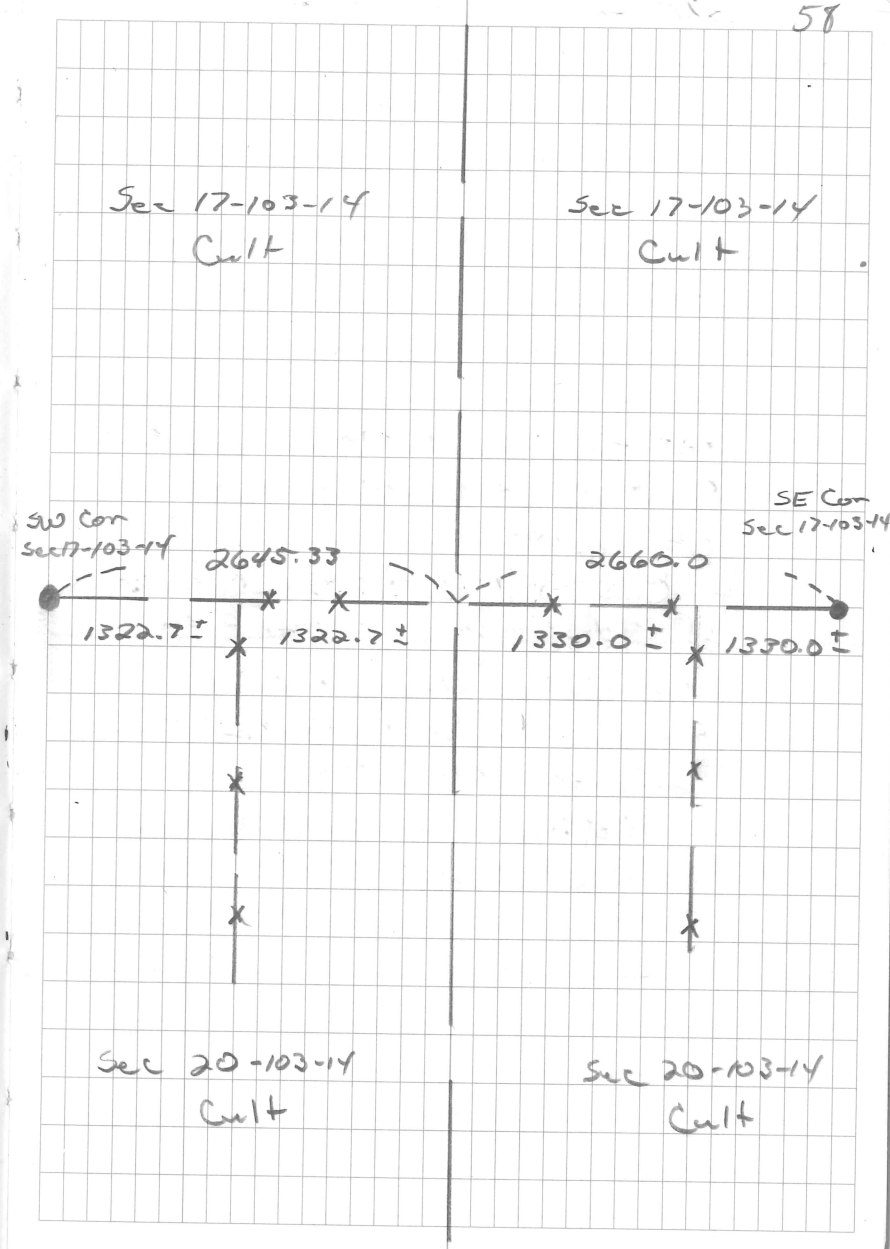

9-21-02 JAS

56

N 1/4 COR SEC 20

USED MIDPT BET SEC CORS FOR E-W POS. & EXISTING E-W FENCE WHICH RUNS ACROSS ELTINE SEC FOL POS. N-S.

THIS COC ALSO FITS 1/16 FOC CLOSES TO EAST & WEST

