9-11-02
Cloudy
75°
JHS
ERB


49

E¼ corn SEC. 26-103-14

NO INFORMATION IN MOUNTAIN
Co. CORNER RECORDS

JHS CREW DUG with MOUNTAIN
Co. BACKHOE, ON ℄ N-S Twp
Rd & E-W Twp Rd.
UNCOVERED 6" x 14 Sq.
LIMESTONE with wood STAKE
ON EAST SIDE 3.5± DEEP.
2'± EAST of ℄ N-S Twp Rd.
PLACED CAP. 5/8" x 16" IRON
ON NORTH SIDE. CAP-13807
SET 5/8" x 16" IRON with
ALUM MON. OVER MON's
FOUND .60± BELOW ROAD
SURFACE.

8-15-6 JHS CREW FD ALUM MON SHOT FOR BASEMAP

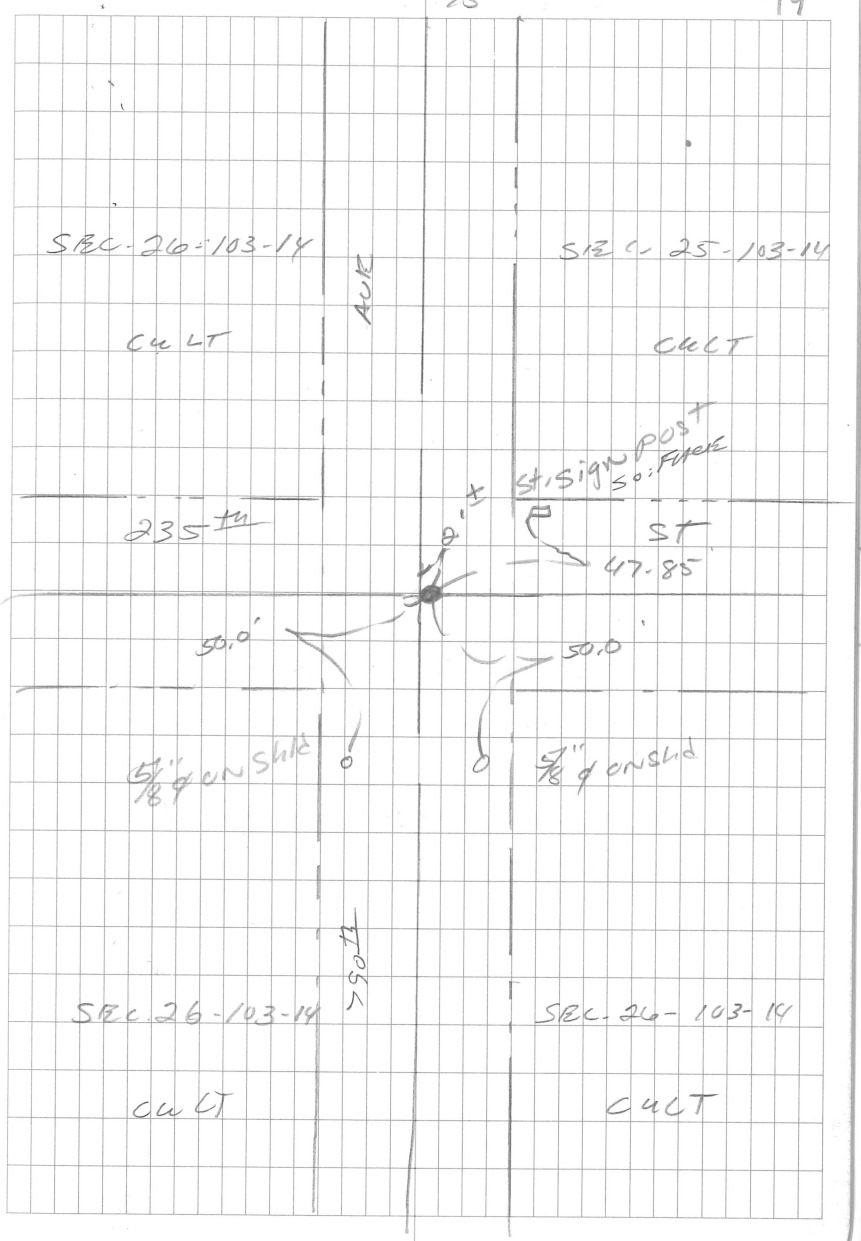

SEC. 26-103-14

COUT PH 67

TO	POL (2)		
BS	FD BRASS CAP (1) SEC. 26		
D	1782.05		
FS	TR. PT (3)		
∠	141° 56' 35"	4255.63	

IN

TO	TR. PT. (3)		
BS	POL (2)		
D	—		
FS	CFP (4)		
∠	303° 47' 34"	5289.60	
FS	CFP (6) @ 1/16th LINE		
∠	331° 49' 49"	2872.38	
FS	SW (5) COR SEC. 26		
∠	215° 28' 00"	196.72	

IN

10-15-02
Cloudy
45°
HLS
FPB

64

