
W 1/4 COR SEC 26
SEE TO # 64

COMPUTED POS. OF
COR TO BE ON ST
LINE BET NW & SW
SEC CORS & INTER
WITH LINE FROM E 1/4
COR EXTENDED WEST
THRU CFP & SE COR
OF W 1/2 NW 1/4

10-25-02 JHS

67

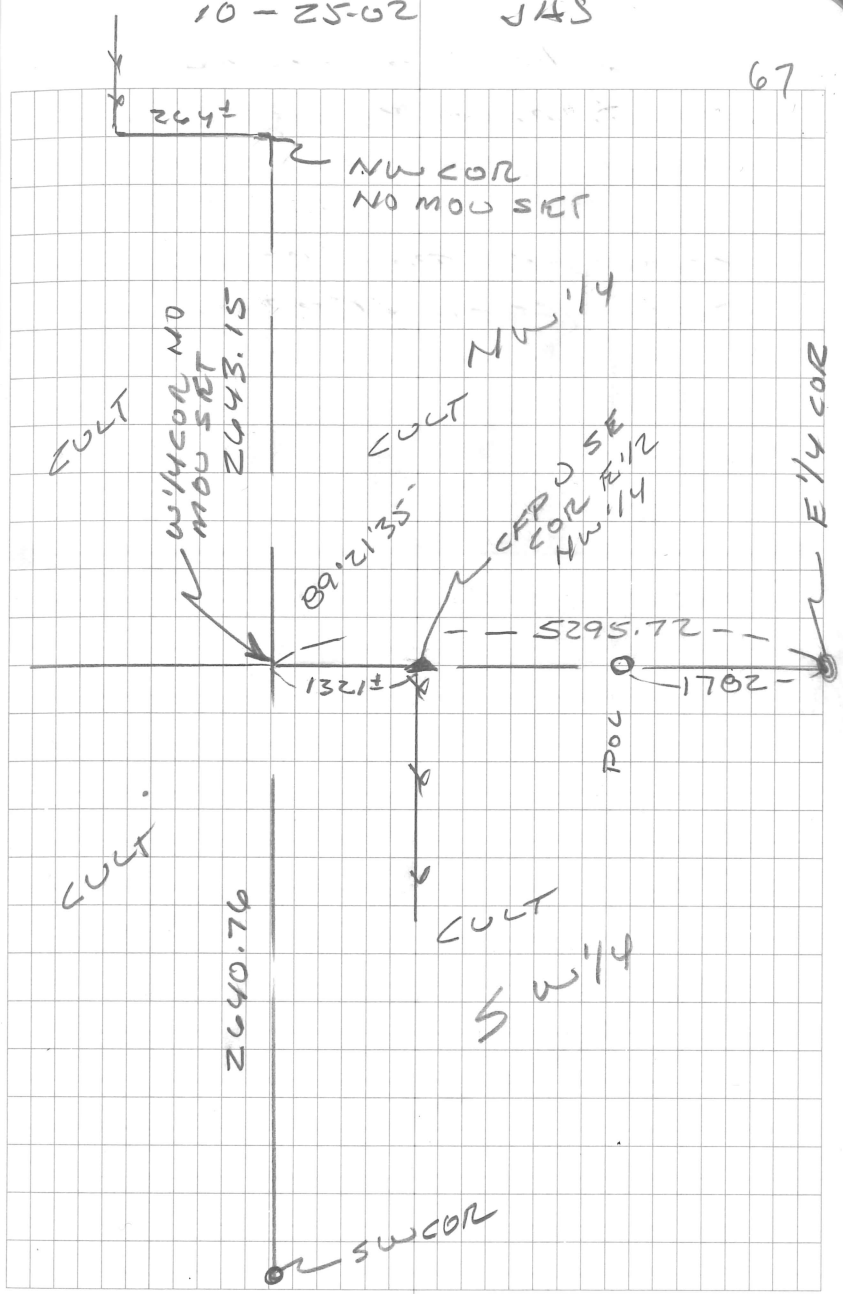

SEC. 26-103-14

COUT PH 67

TO	POL (2)		
BS	FD BRASS CAP (1) SEC. 26		
D	1782.05		
FS	TR. PT (3)		
∠	141° 56' 35"	4255.63	

IN

TO	TR. PT. (3)		
BS	POL (2)		
D	—		
FS	CFP (4)		
∠	303° 47' 34"	5289.60	
FS	CFP (6) @ 1/16th LINE		
∠	331° 49' 49"	2872.38	
FS	SW (5) COR SEC. 26		
∠	215° 28' 00"	196.72	

IN

10-15-02
Cloudy
45°
HLS
FPB

64

