
5 1/4 COR SEC 22

2002 JHS CREW FOUND CORNER FENCE POST @ THIS LOCATION & TIED IT IN WITH GPS THE. FLG POST HAS LINES OF OCC N-S-E-W & 1/16 FLG LINES WITHIN SEC


10-24-03 JHS

73

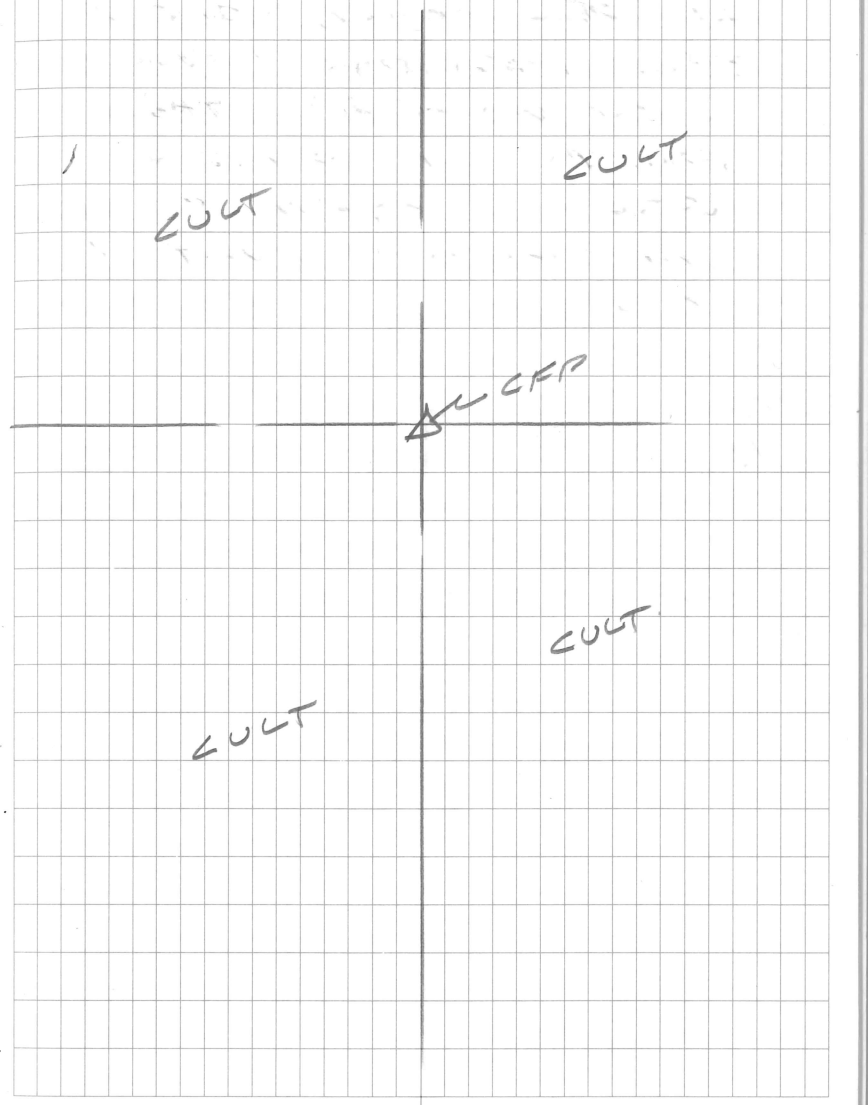

S 1/4 Cor Sec 22-103-14

Used steel Fence Post
Found at 3-way Field
Division

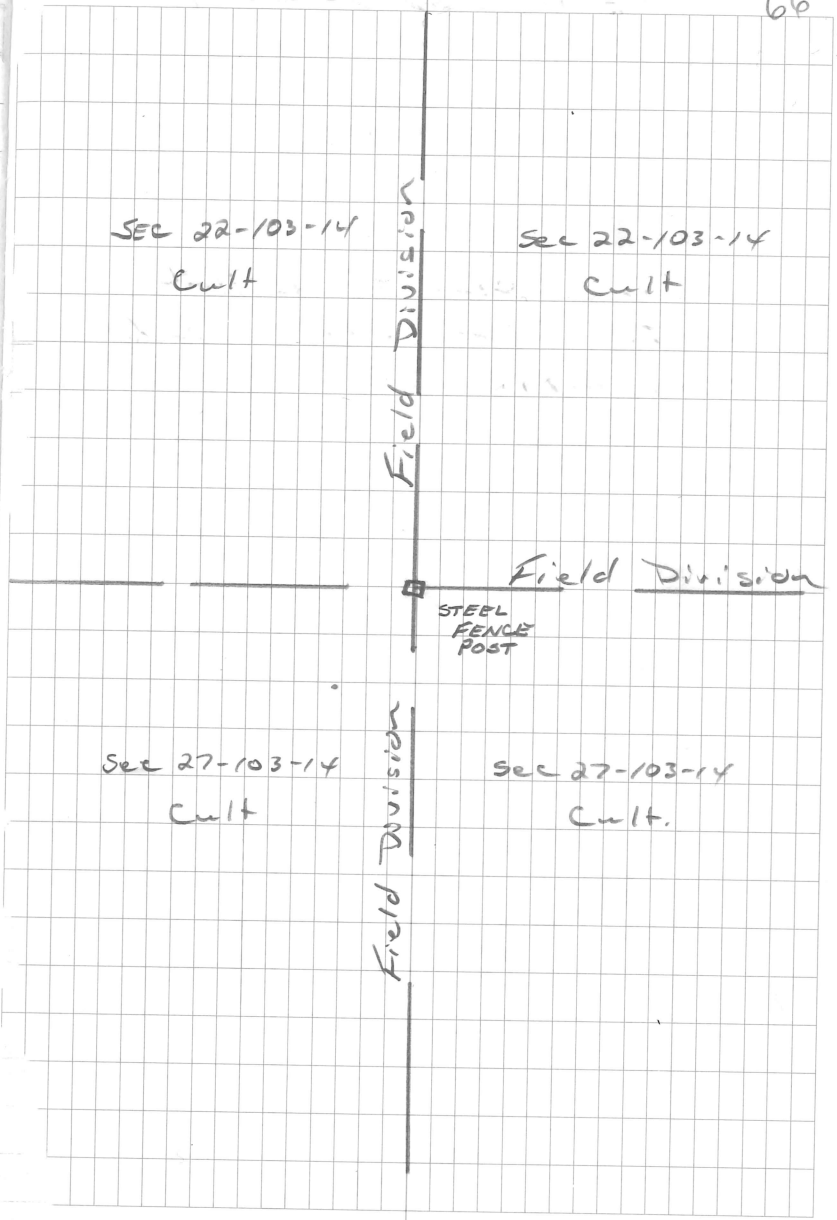

N¼ SEC. 27 – 103-14

IN Fld

NEED to SET

