
S¼ COR SEC. 26-104-14

MOWER CO. RECORDS STA'-
INP STONE,

JHS CREW LOOKED OVER AREA, CORNER would be off Shoulder of twp Rd which FIELD DRIVE WAS INSTALLED, with 12" CULVERT PLACED AT POINT of WEDGE CORNER would have been.
COMPUTED LOCATION OF INTER ℄ E-W & N-S TWP ROADS - THIS LOC ALSO FITS FNC LINE ON W. LINE NE¼

12-27-06 SET CIM AT Computed location
MHS USING GPS - SET TIES

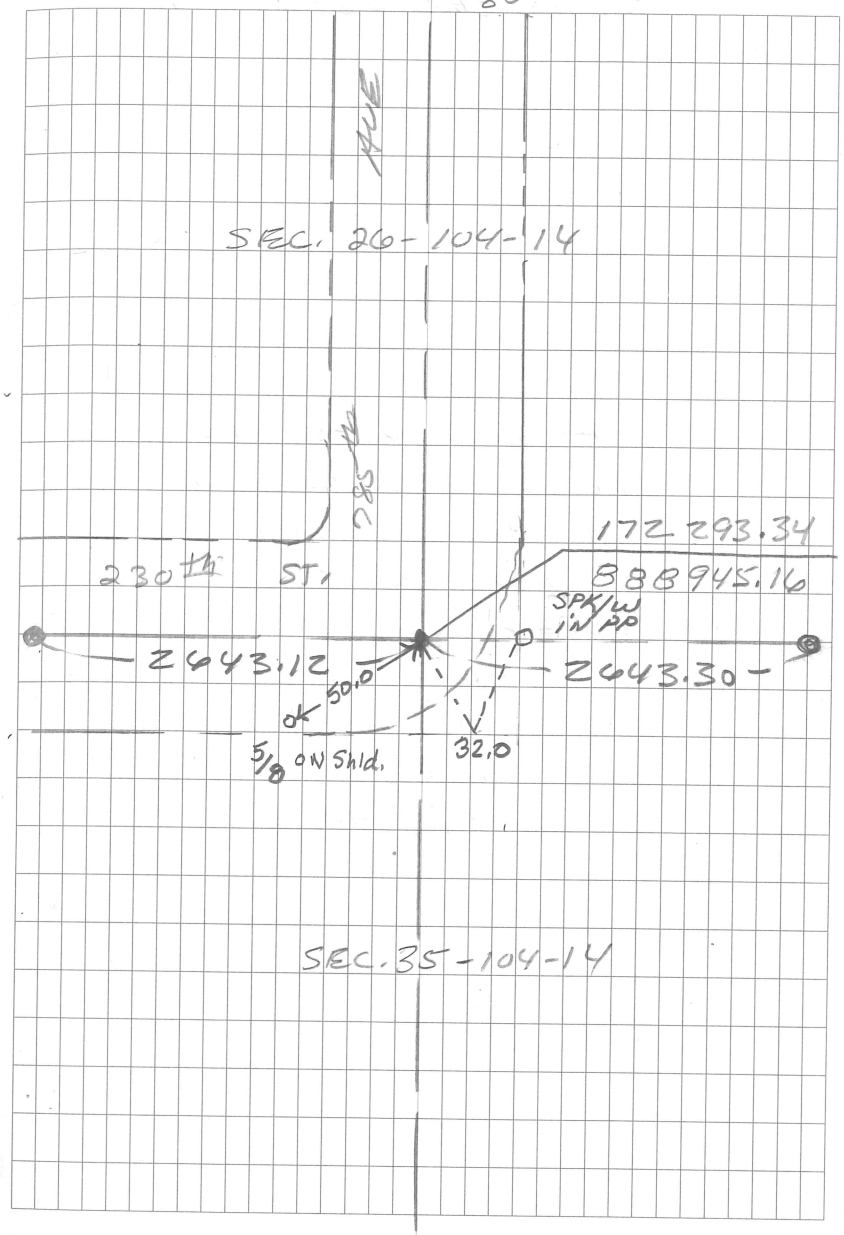

SEC. 26-103-14

COUT PH 67

TO	POL (2)		
BS	FD BRASS CAP (1) SEC. 26		
D	1782.05		
FS	TR. PT (3)		
∠	141° 56' 35"	4255.63	

IN

TO	TR. PT. (3)		
BS	POL (2)		
D	—		
FS	CFP (4)		
∠	303° 47' 34"	5289.60	
FS	CFP (6) @ 1/16th LINE		
∠	331° 49' 49"	2872.38	
FS	SW (5) COR SEC. 26		
∠	215° 28' 00"	196.72	

IN

10-15-02
Cloudy
45°
HLS
FPB

64

