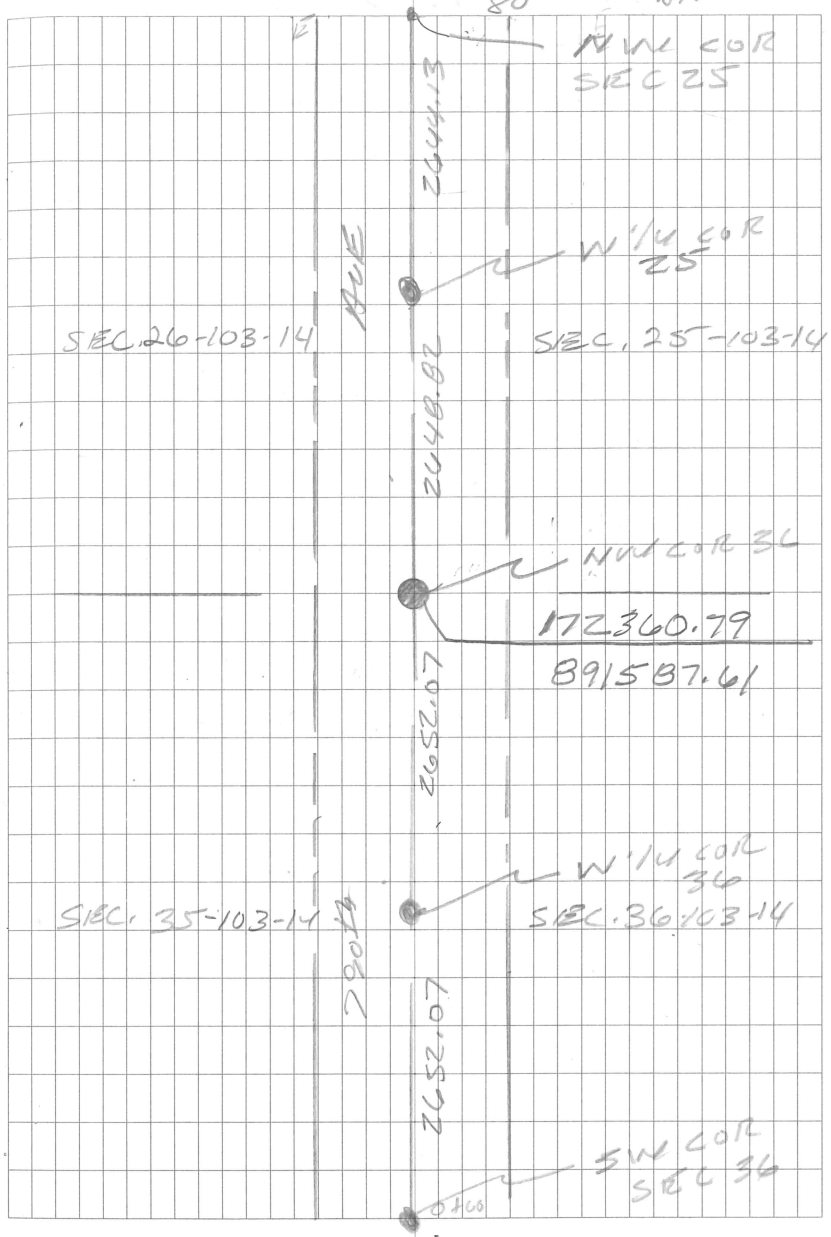
SE COR SEC. 26-103-14

NO INFORMATION FOUND
IN MOWER CO. RECORDS

JHS CREW dug with
RAY TUCKER BACKHOE
AT POINT 26+50 ± NO. of
SEC. 35 AND 26+50 ± SO. of
EAST ¼ of SEC. 26.
FOUND NO EVIDENCE
of POS CORNER
COMPUTED POS. OF COR
USING ℄ OF EXISTING TWP
ROAD & DIST OF 2652.07'
N OF W¼ COR SEC 36

8-10-06 JHS
CLOUDY 80° MNH 6


NW COR SEC 25
W¼ COR 25
SEC. 26-103-14
SEC. 25-103-14
NW COR 36
1712360.79
891587.61
W¼ COR 36
SEC. 35-103-14
SEC. 36-103-14
SW COR SEC 36
2652.07
2652.07
2652.07

SEC. 26-103-14

COUT PH 67

| | | | |
|---|---|---|---|
| TO | POL (2) | | |
| BS | FD BRASS CAP (1) SEC. 26 | | |
| D | 1782.05 | | |
| FS | TR. PT (3) | | |
| ∠ | 141° 56' 35" | 4255.63 | |

IN

| | | | |
|---|---|---|---|
| TO | TR. PT. (3) | | |
| BS | POL (2) | | |
| D | — | | |
| FS | CFP (4) | | |
| ∠ | 303° 47' 34" | 5289.60 | |
| FS | CFP (6) @ 1/16th LINE | | |
| ∠ | 331° 49' 49" | 2872.38 | |
| FS | SW (5) COR SEC. 26 | | |
| ∠ | 215° 28' 00" | 196.72 | |

IN

10-15-02
Cloudy
45°
HLS
FPB

64

