
N 1/4 COR Sec. 3-103-15

JAS CREW DUG & TAIS LOCATION WITH BACK HOE & FOUND NO EVIDENCE OF PLS COR SET COR ON STRAIGHT LINE BETWEEN SEC COR'S IN LINE WITH FENCES N & SOUTH, SET CIM WITH GPS PER JOHN SCHULTE FOR BASEMAP

8-22-06 JAS 19

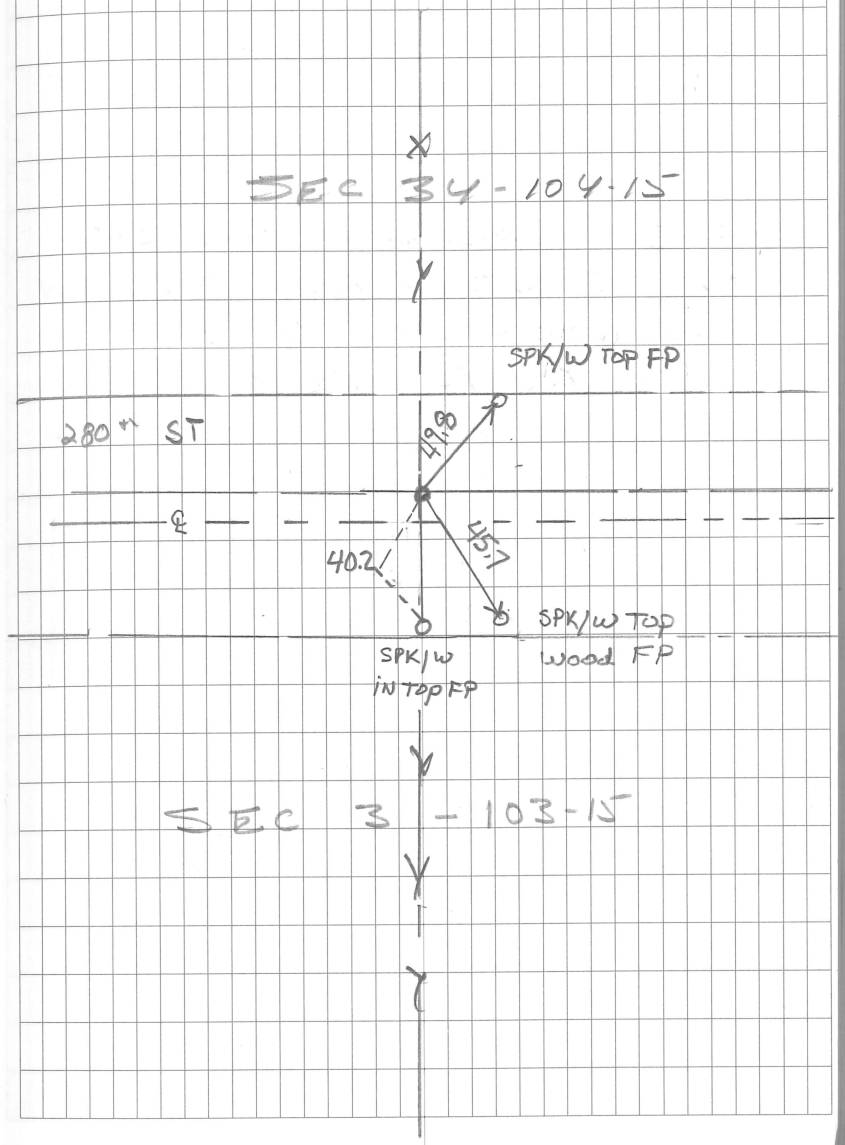

11-04-05 HLS
Cloudy MHS
45°

61

Sty Cor SEC 34-104-15

NO INFORMATION IN
MOWER Co. CORNER RECORDS.

JHS CREW dug with RAY TRUCKEN
BRICKHOUSE, ON & E-W TWP RD
AND IN LINE with LINE FENCE
NORTH AND FENCE SOUTH,
Dug down to virgin Soil
AND FOUND NO EVIDENCE of
PLS CORNER, SEE GRAND MEADOW
BOOK 2 FOR TIES.

