
NW CORNER SEC. 2 - 103 - ~~2T~~ 15
Cert. Filed 11-24-92 by JHS

TIES FROM MOWER CO. HWY. DEPT.

8-22-06 JHS CREW FOUND 1/2" Ø IRON IN BRIDGE DECK & SHOT WITH GPS.

4-1-92

5.

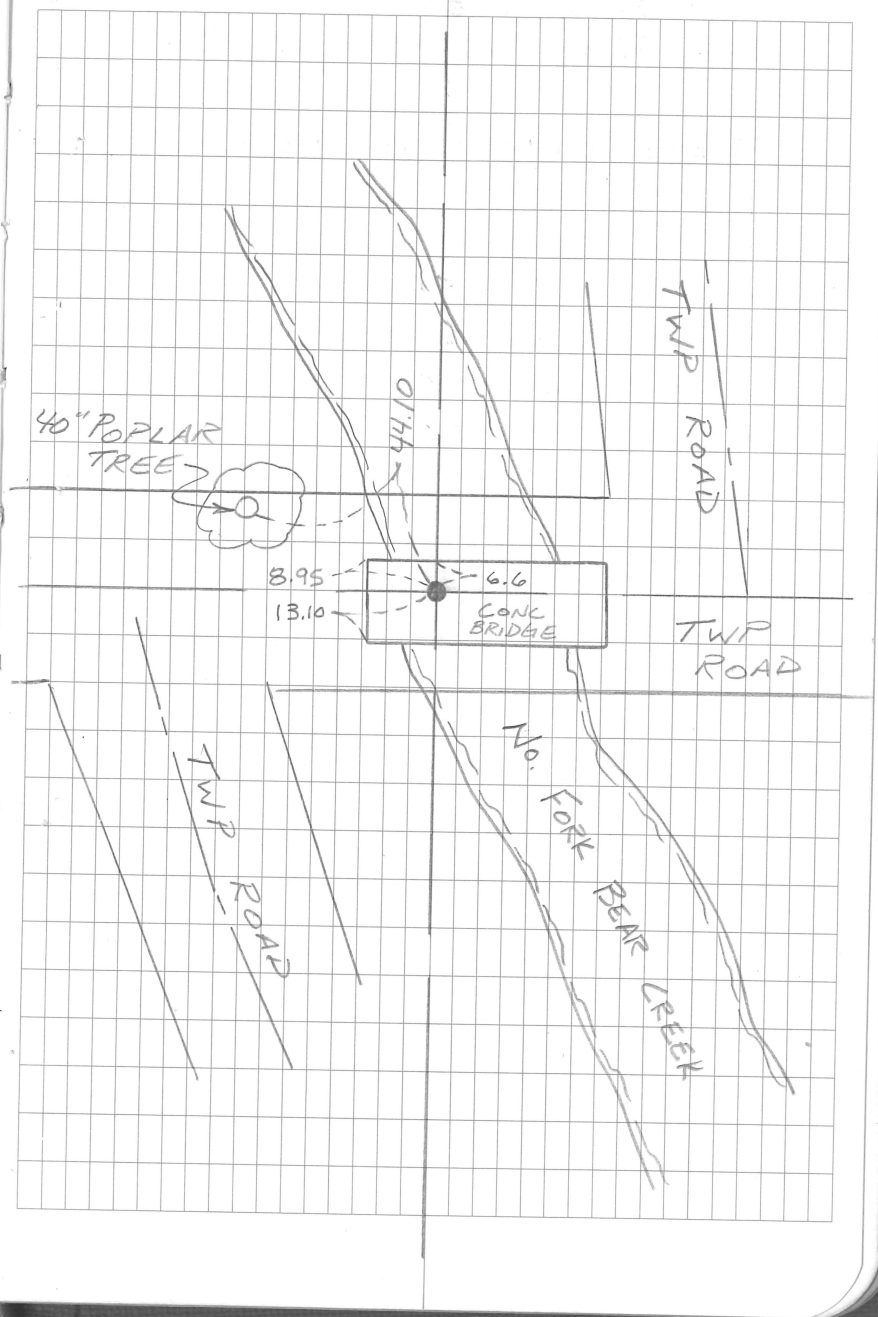

SE cor SEC. 34-104-15

"NW" corner appears to fall in Bridge

See Grand Meadow Tie Book for Information

11-04-05
Cloudy 46
HLS
MHS

60

