SE COR SEC. 6-103-15

6-13-90 RAY TUNKER

FOUND CONCRETE MON 2.5' WEST of CENTERLINE 0.50' DEEP. FOUND ANOTHER CONC MON 1.80' BELOW FIRST MON.

TIES - PKN PP - NW - 55.35

PKIE PP - SW - 65.11

½" REBAR SE - 82.98

JHS CREW Dug with MOWER CO. BACKHOE. Dug AT LOCATION of ½" IRON FOUND.

UNCOVERED CONC MON. with IRON ROD IN CENTER. 2.5'± DEEP 1.10' WEST AND 2.40' SO. of ½" IRON PLUGGED CAPPED 5/8" x 16" IRON (13807) ON NORTH SIDE of MON.

SET 5/8" x 16" IRON OVER MON. FOUND @ 60'± BELOW RD. SURFACE.


8-3-06 CPU. FOUND 5/8" ø ; SHOT w/ GPS.

DATE? - SET - ALUM MON.

JHS 1-19-04 MON. DISTROYED - NEED to BE PLACED & CHECK TIES

8-12-02 CLOUDY 70-0 JHS SAT

34

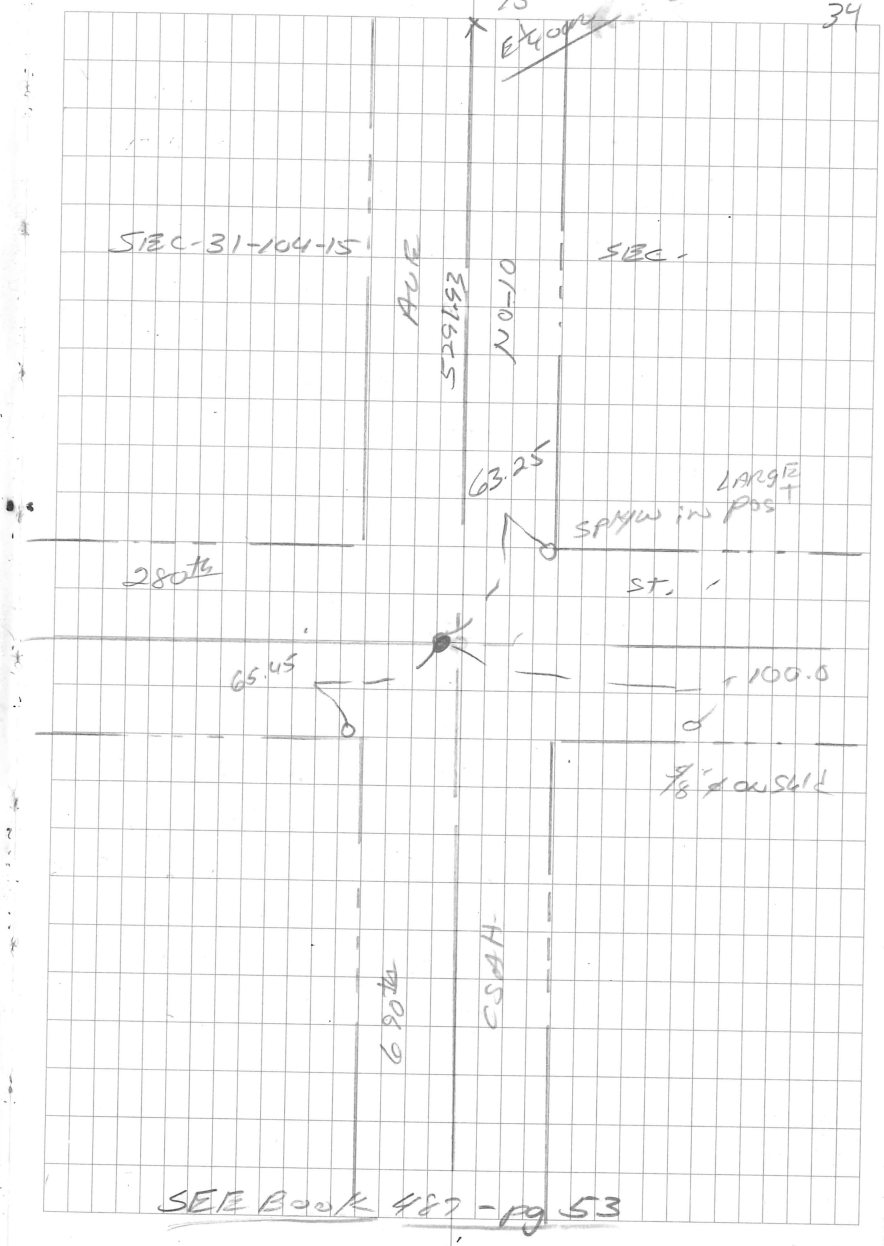

SEE Book 487 - pg 53