
8-4-06
Cloudy
80°
JHS
MDH

¼ COR SEC. 4-103-15

NO INFORMATION FOUND
IN MOWER CO. RECORDS

JHS CREW dug with
RAY TUCKER BACKHOE
ON ℄ E-W Twp Rd
AP in LINE with Field
Division North.
Dug down 1'± AND cuts
in SANDY-CLAY SOIL, CORNER
would HAVE BEEN disturbed
AT TIME of ROAD CONST.

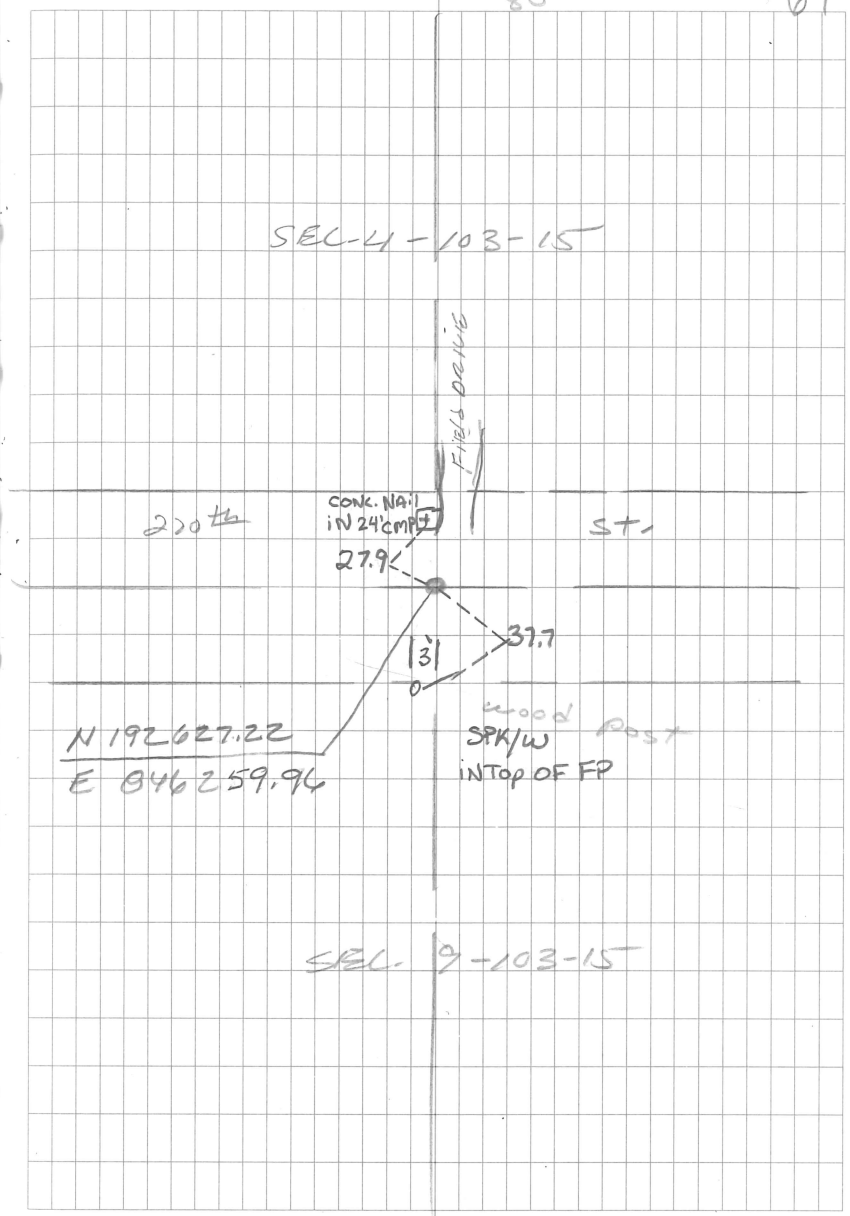

8-22-06 JHS CREW SET CIM ON ℄
E-W ROAD ∋ SPLIT
BETWEEN SEC CORS
WHICH FITS EXISTING
OCCUPATION TO SO ¼
NORTH