S¼ COR SEC. 7-103-15

No Information Found in Mower Co.

TO	POL	
BS	SE COR SEC. 7	
D	2210.86	5136.44
BS	SW COR SEC. 7-103-15	
∠	180°00'00"	2925.58
FS	S¼ COR SEC. 7-103-15	
∠	180°00'00"	4127.64

Set corner by using County Road Plan.

Co. Dist. From SW cor to SE cor 5137.90 – Found = 5136.44


1.46 short. Set corner on straight line, between SW & SE corners. Held Co. Dist. Sec cor to ¼ cor. Set cast iron @ road surface, corner fits occupation north & south.

9-9-05 Tied of corner.

7-31-06 Found corner marker shot with GPS for basemap
MHS
AKP

7-21-00 HLS BJJ

24

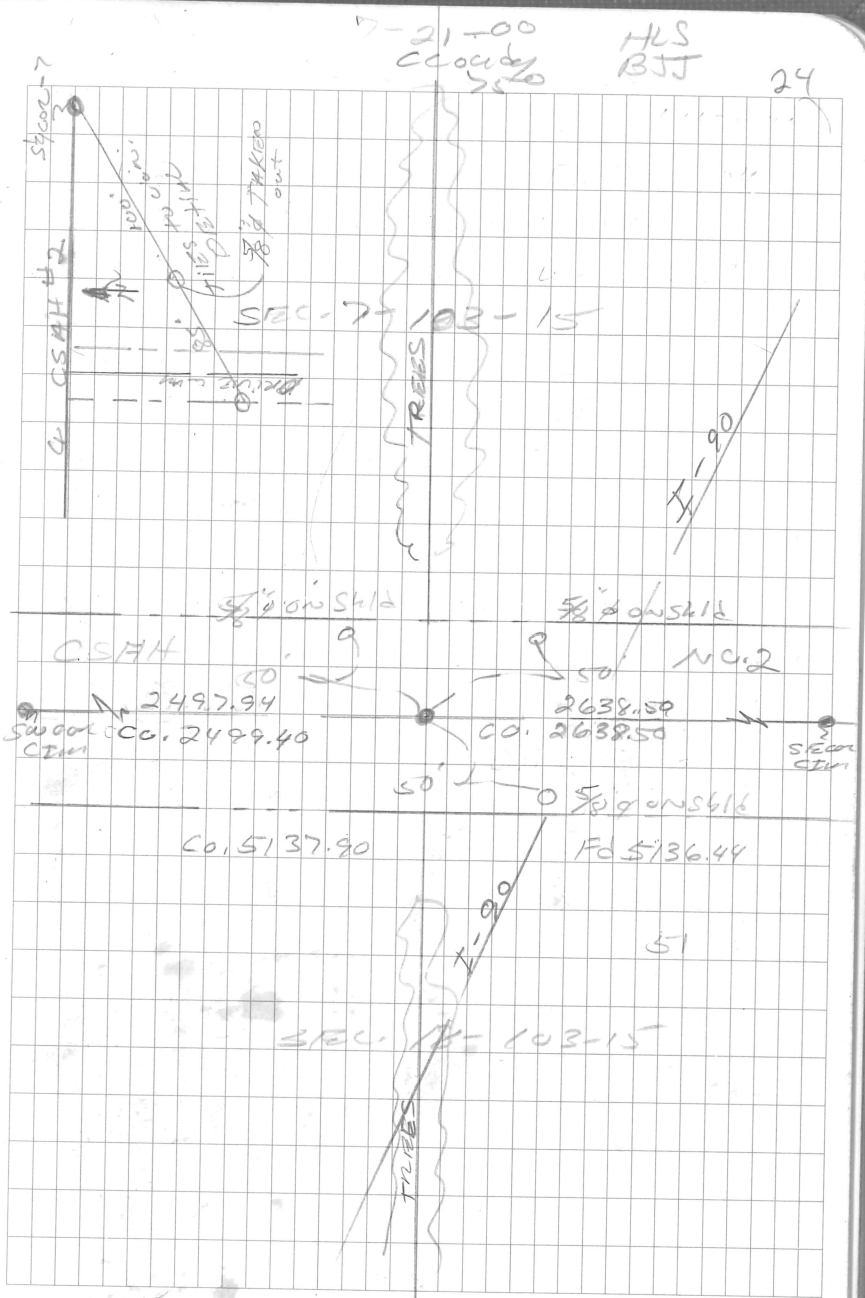

185