Cert. Filed 2-24-95 by JHS

NE COR SEC 10


NOTE! SET COR USING SINGLE PROPORTION BET E1/4 COR SEC 3 & E1/4 COR SEC 10, THIS FITS 1/4 MILES IN ADJOINING SEC. & FALLS IN SEC 3

467.8
.12
479.8
+856.3
1336.1
x2
2672.2
-479.8
2192.4

2659.52 E
2657.0 W

2640.17 SO.
89°12'10"

2001.2
1358.9 40°14' FCE
1767.0 88°22' FCW

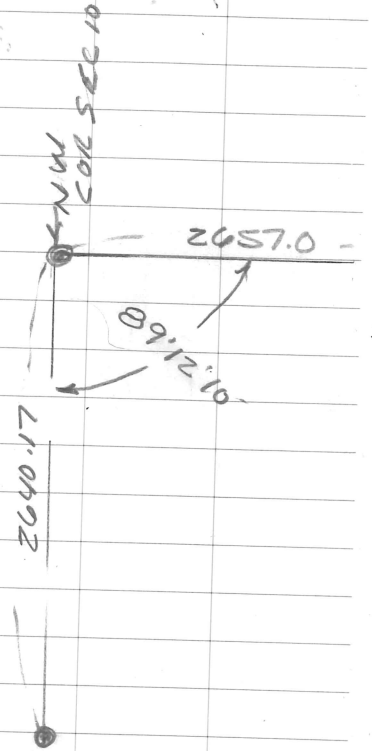

1-10-95
PC
JHS
KTW

