cent. filed by VHS 3-3-95


SE COR SEC. 11 - T103N - R16W

Mower county RECORD STATE CONC. MONUMENT IN PLACE.

Did not dig SECTION CORNER At this Point, MONUMENT APPEARS to HAVE BEEN DESTROYED WHEN MH WAS INSTALLED. MH is ON ℄℄ of ROAD North & South — AND ROAD EAST & WEST.

10-26-94 CLEAR 60

HRS JSR 16

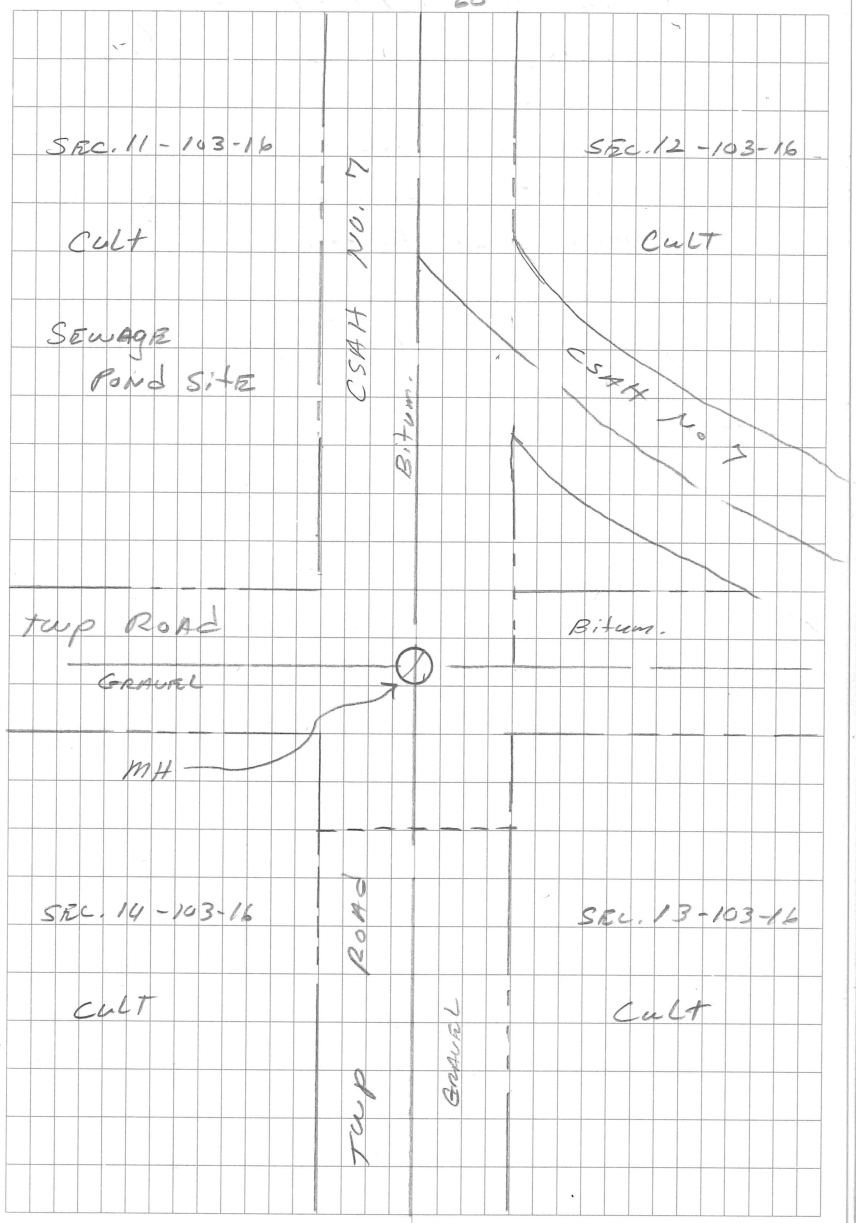

SE COR SEC 11

Cert. Filed 3-3-95 by JHS

SET COR USING DATA FROM CSAH # 7 & CSAH #2 R/W PLANS. EXTENDED ℄ OF CO RD # 7 FROM WEST & INTER N-S ℄ OF 24 & SHOWN THIS COC FITS PLAN DIST FROM NORTH WHEN USING CORN. STA's ON PI & 1/4 SEC COR

NO MON SET, AS IT WOULD BE IN MH COVER.

2005 FOUND THAT MH COVER HAD BEEN RAISED & MOVED DURING RESURFACING & COUNT OF CSAH #7 USED DIST & ℄ FROM E1/4 COR & S1/4 COR SEC 11 AS SHOWN IN SKETCH TO COMPUTE COC OR COR

1-10-95 JHS

