E 1/4 COR SEC 24-103-16

Cert. Filed 8-16-96 by JHS

RMT Set dr. II hole by stationing

Ray Tucker used cor for surveys in NE 1/4.


Set CIM by stationing from R/W markers & DOT coords for E. Calc position fit R/W markers & DOT E within 0.7'

6-5-03 Replaced concrete with spindle. Tie's good

7-17-96 JHS

PC +70.

37

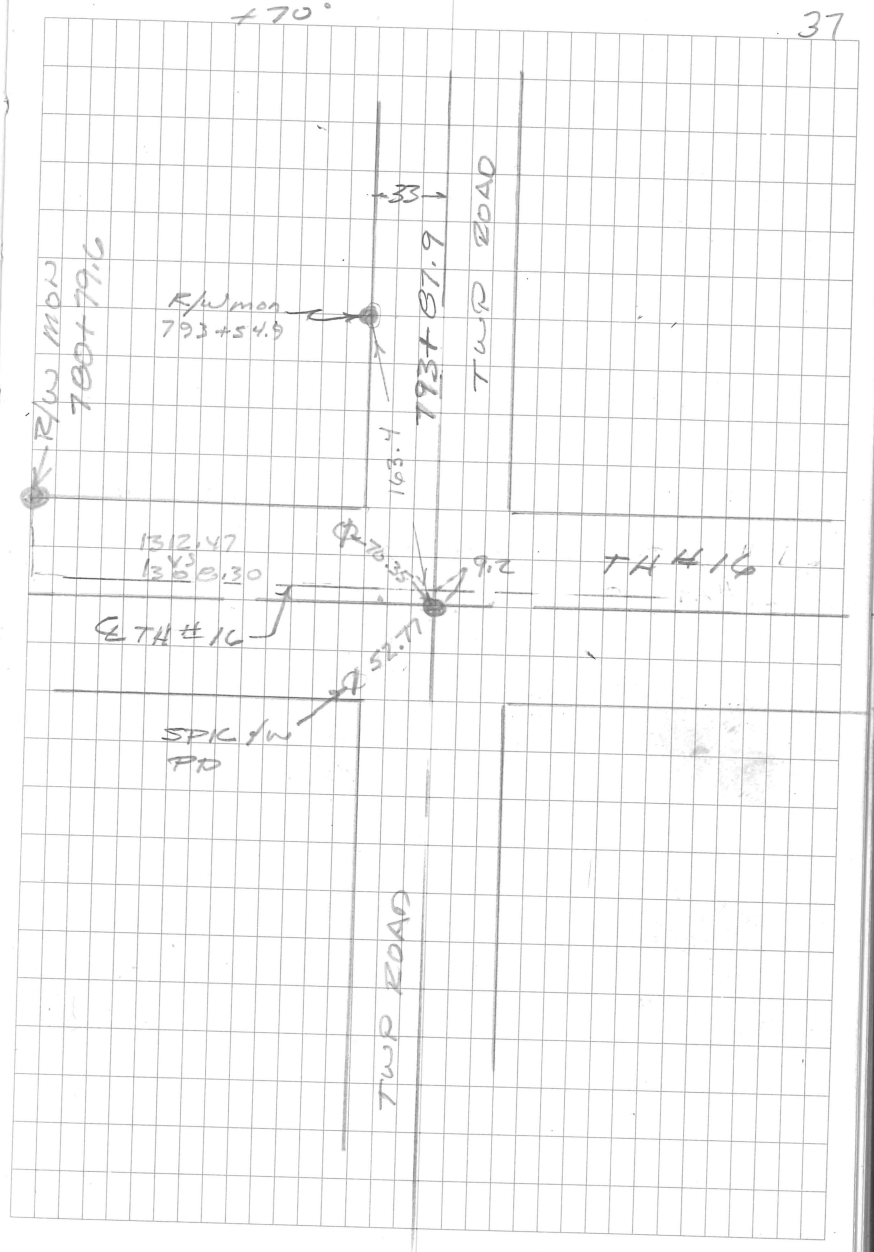

8-26-99 HLS
CLEAR DEK
85°.

77

RESET SW cor SEC. 18-103-17
CORNER DESTORYED by CONSTRUCTION
(REPLACE Bridge) (MOWER Co.)

TO NW cor SEC. 18 — FD CTM
BS N¼ cor SEC. 18
D 2821.74 V.S 2821.77 — FD CAP 5/8"ϕ
B W¼ cor SEC. 18
∠ 89°36'35"
D 2648.85
FS N¼ cor SEC. 13 — FD CTM
∠ 178°54'40"
D 2657.03

TO W¼ cor SEC. 18
BS NW cor SEC 18
D 2648.87
FS SW cor SEC. 18
∠ 180°01'03"
D 2657.80
FS TR. PT-
∠ 180°14'04"
D 3553.90

