SE COR SEC. 13-103-16


6-04-03 JHS CREW LOCATED CAPPED PIPE No. 10078 in South Rd. Ditch of EAST BOUNDARY LANE - I-90 with STEEL POST @ CORNER

1974 MNDOT R/W map shows 8" Field stone and 2x2 hub @ corner.

No evidence of stone was found. Corner was retraced from DOT stationing on I-90 @ 841+45.57 & 91.33' S. of EB E. Stationing is accepted as best evidence of stone position which is accepted as perpetuation of orig. location of PLS cor.

7-14-03 HLS
Cloudy 80° TW

61

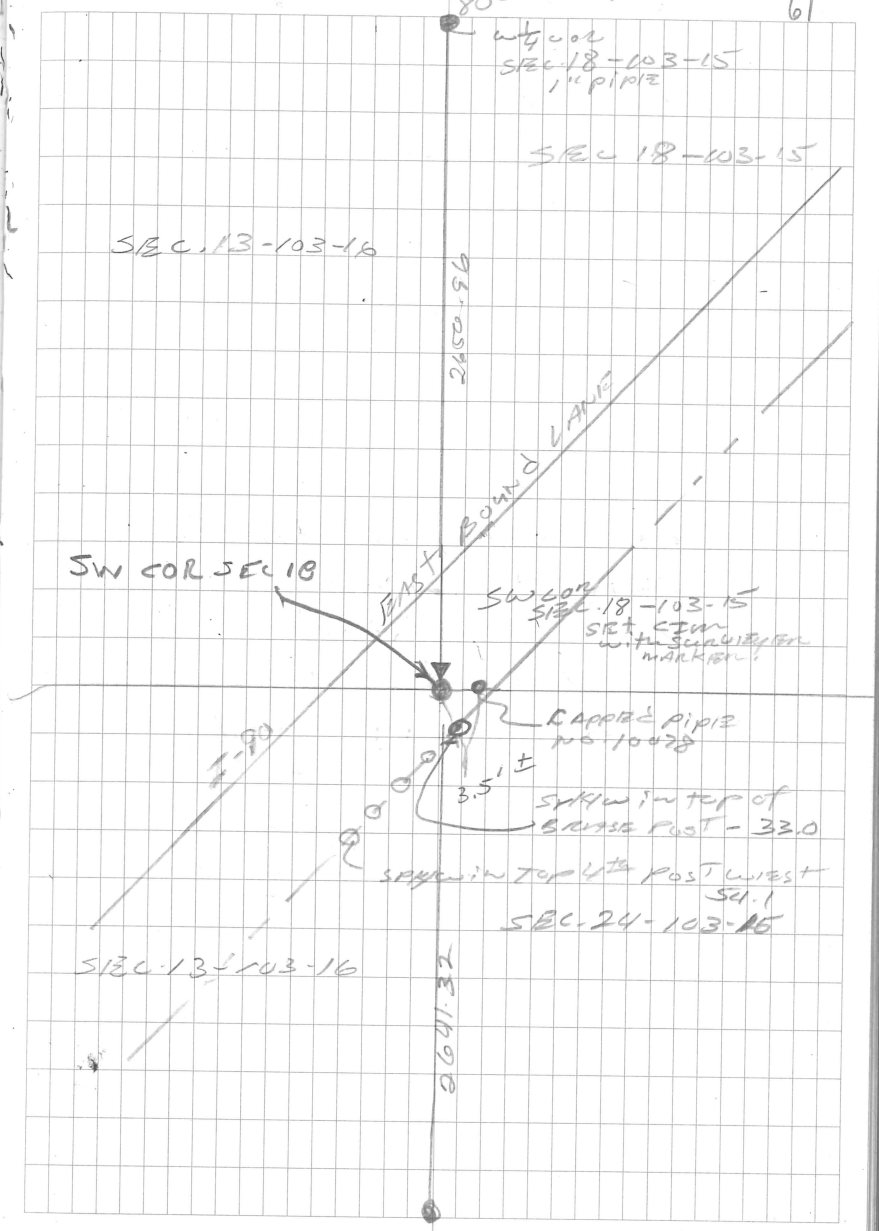

NE cor Sec 24-103-16

3-8-01 Fd pipe & Cap 10078 did not fit MNDOT position of 8" stone. Investigate further before using.

SJT, CPN

8-26-99 HLS
CLEAR DEK
85°.

77

RESET SW cor SEC. 18-103-17
CORNER DESTORYED by CONSTRUCTION
(REPLACE Bridge) (MOWER Co.)

TO NW cor SEC. 18 — FD CTM
BS N¼ cor SEC. 18
D 2821.74 V.S 2821.77 — FD CAP 5/8"ϕ
B W¼ cor SEC. 18
∠ 89°36'35"
D 2648.85
FS N¼ cor SEC. 13 — FD CTM
∠ 178°54'40"
D 2657.03

TO W¼ cor SEC. 18
BS NW cor SEC 18
D 2648.87
FS SW cor SEC. 18
∠ 180°01'03"
D 2657.80
FS TR. PT-
∠ 180°14'04"
D 3553.90

