
SW cor SEC. 19-103-16

NO INFORMATION FOUND IN MOWER CO. CORNER RECORDS

JHS CREW DUG WITH BACKHOE UNCOVERED 1½" x ½" FLAT IRON 3.0' LONG, FOUND OTHER BWD FENCE OF PLS CORNER. LOWER FLAT IRON AND SET 5/8" x 16" IRON WITH CAST IRON MON. OVER MON. FOUND. .60' BELOW RD. SURFACE

7-22-03
Cloudy
75°
JHS
TLM
60

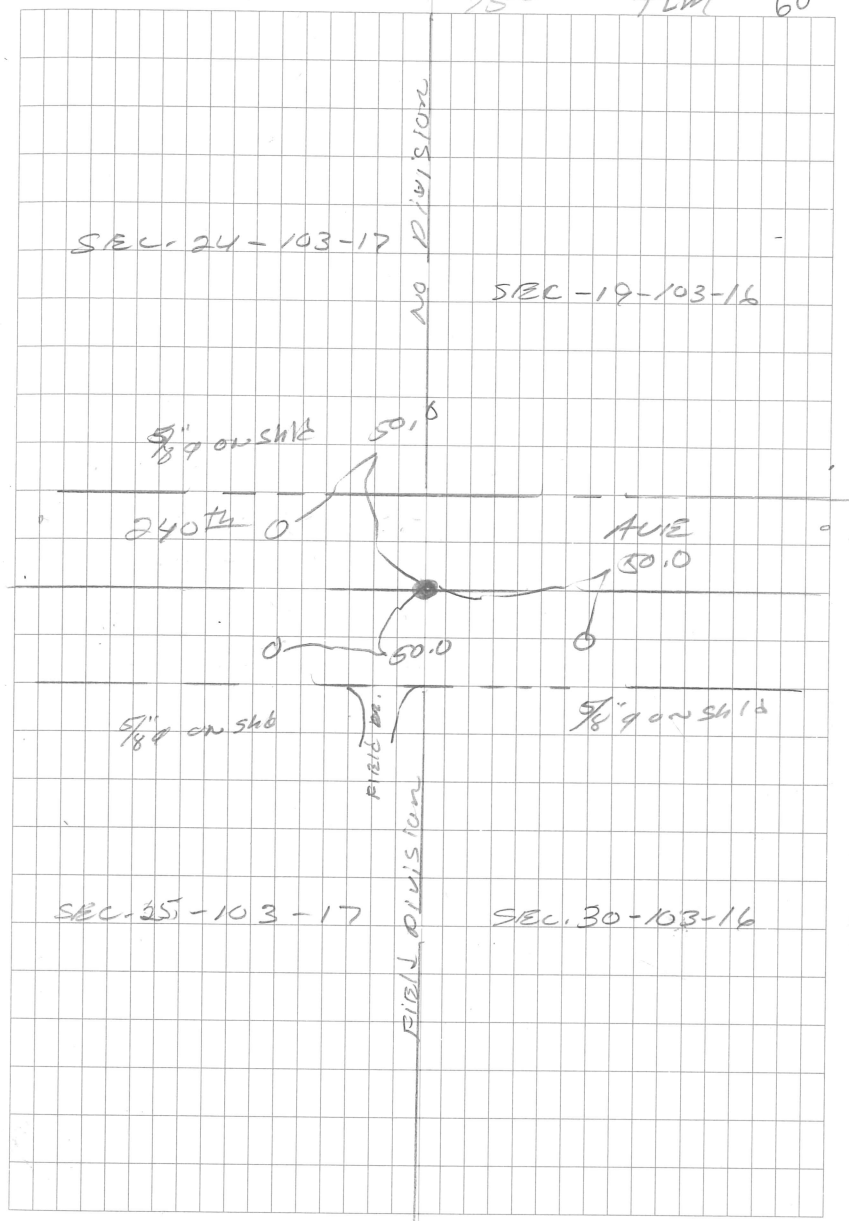

NE cor 25-103-17

2-28-03 JHS crew fd flat iron
0.3 below rd surf.

2-28-03

11

