NOV. 1991 SAW 7V.


SE CORNER SEC. 1-103-18

Cert. Filed by JHS 10-17-96

OCT 22, 1991 JH's CREW DUG WITH Co. BACKHOE AND FOUND HARRISON CIM OVER 5" DIA. CLAY TILE WITH 3/4" ϕ CAST IRON IN CONC. 3' DEEP. FOUND NO FURTHER EVIDENCE OF PLS CORNER. SET CIM.

2-13-09 SJT/KTW reset mag nail @ cor w GPS

9/11/12 MDH Set Survey Marker Flush. Set (2) Magnails as ties on fogline to SW & SE @ 50'.

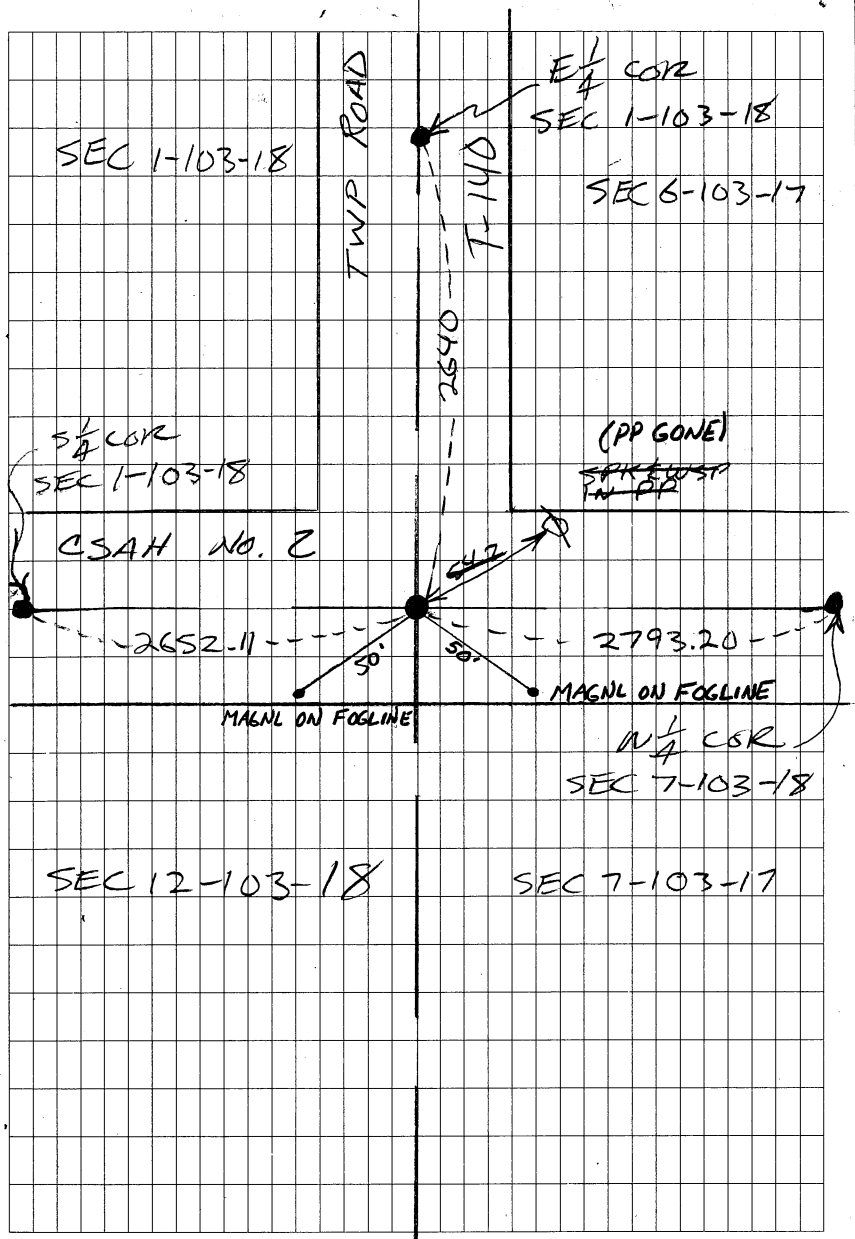

NKJ Cor 7-103-17

Dug on ℄℄ of N-E-KJ roads and found a 5/8"ϕ iron over a 5/8"ϕ iron cast in conc in a 6" dia clay tile 2.5' below road surface set CIM over

9/11/12 MOH Set Survey Marker Flush.
Set ② Magnails as ties on fogline to SW & SE @ 50'.

