
Nt cor SEC. 13 - 103 - 18
Certified by JHS 3-17-97
No Information Found
in Mower Co. Records

1991 JHS CREW LOCATED @ CAST IRON MON. @ this LOCATION

1996 JHS CREW Located a 5/8" ø ON ℄ of N-S County ROAD NO. 61 & ℄ of twp ROAD EAST. CAST IRON MAY HAVE BEEN DESTORYED, RE PLACE CAST IRON. MON.

12-26-96
CLOUDY
0°
HLS
JHS IV
49

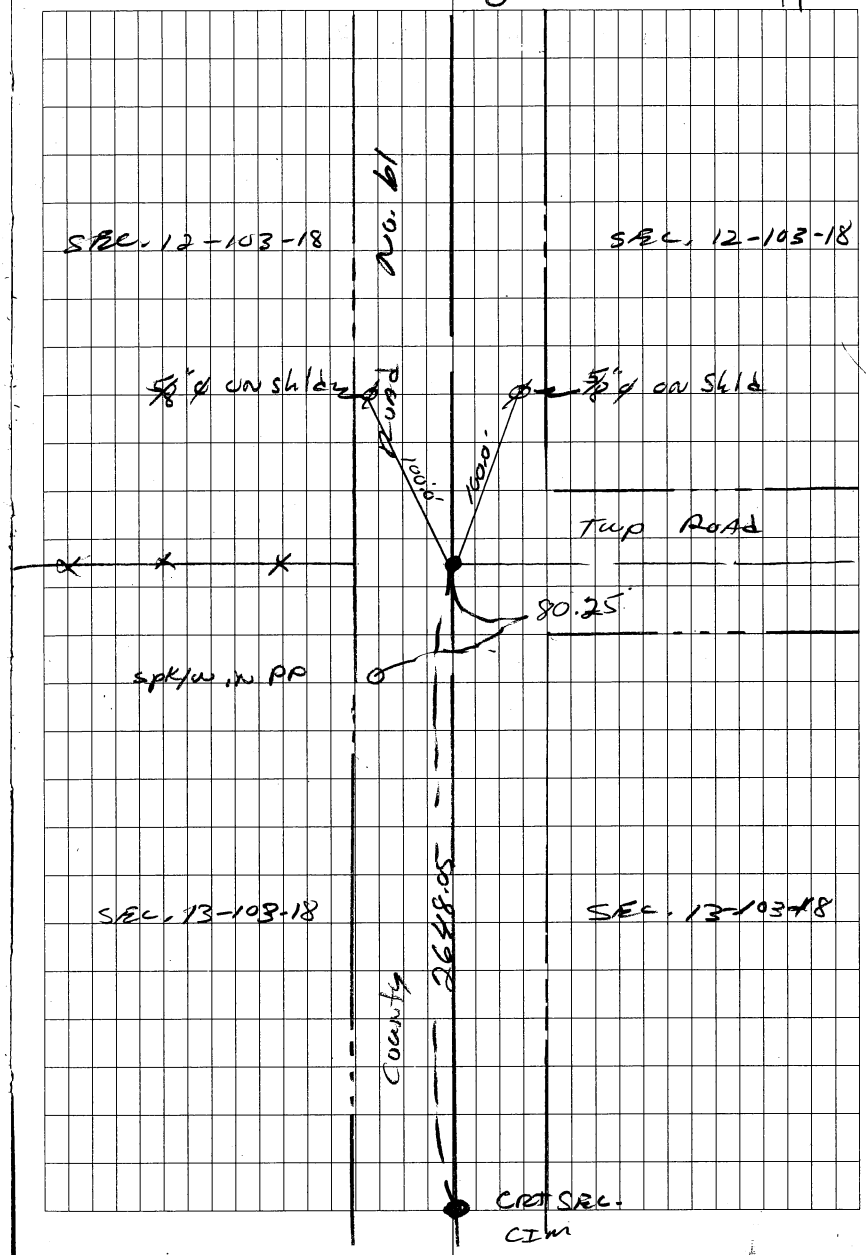

8-26-99 HLS
CLEAR DEK
85°.

77

RESET SW cor SEC. 18-103-17
CORNER DESTORYED by CONSTRUCTION
(REPLACE Bridge) (MOWER Co.)

TO NW cor SEC. 18 — FD CTM
BS N¼ cor SEC. 18
D 2821.74 V.S 2821.77 — FD CAP 5/8"ϕ
B W¼ cor SEC. 18
∠ 89°36'35"
D 2648.85
FS N¼ cor SEC. 13 — FD CTM
∠ 178°54'40"
D 2657.03

TO W¼ cor SEC. 18
BS NW cor SEC 18
D 2648.87
FS SW cor SEC. 18
∠ 180°01'03"
D 2657.80
FS TR. PT-
∠ 180°14'04"
D 3553.90

