
S¼ cor SEC-11-103-18

FOUND INFORMATION OF CORNER IN MOWER CO. RECORDS.

1958 JONES ENG CREW USED FNC INTER E-W-S DURING SURVEY FOR PLAT OF PLEASANT VIEW ADD.

1998 JHS CREW SET CORNER IN LINE FENCE E-W & LINE FENCE SOUTH. SET TEMP SPK/W USING MOUS FOUND PLEASANT VIEW ADD.

2-28-00

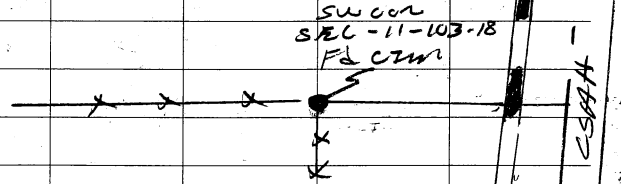

JHS CREW UNCOVERED SPK/W & RESET CORNER WITH 5/8" X 16" IRON WITH CAST IRON MON OVER AT GRD SURFACE, NORTH SIDE OF CORNER FENCE POST ON R/W LINE.

2-28-00 CLOUDY 50° HLS DIK 53

