
SE cor SEC 21-103-18

Cert Filed by JHS 1-27-97

CORNER WAS set by Ron Olson
CAP NO. RJO 11009, LOCATION
IS IN AGREEMENT WITH
EXISTING PLATS & MONUMENTS
IN THIS AREA, & ALSO
IN AGREEMENT WITH JHS
& MHD LOCATION.

12-16-95
Cloudy
25°
HLS
EGW
37

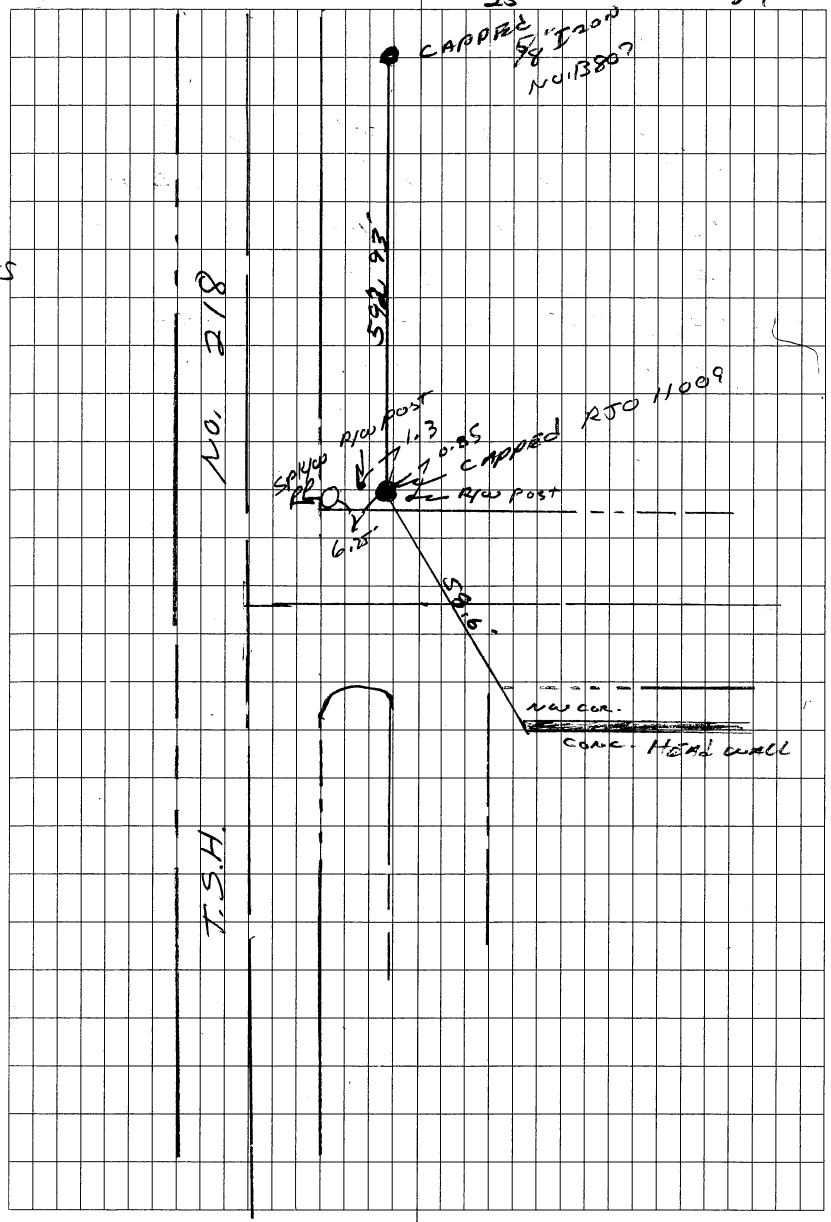

SE COR SEC. 21 - 103-18
Cont. Filed by JHS 1-22-47
TIES to SE COR (SEE pg. 37)

SEE Book 422 - pg. 21

