7-15-04
Cloudy
80°
HLS
MHS

59

E¼ cor SEC 22-104-14

NO INFORMATION FOUND IN MOWER Co. CORNER RECORDS

MN. Hwy R/W MAP SHOWS CORNER 307.0' EAST of P.O.T. S.T.A. 499+89.4 @ 3-WAY FENCE INTERSECTION.


SEARCHED AERIA AND FOUND NO MON.

RESET CORNER USING INFO FROM SH. #63 R/W MAP.

SET 5/8" X 16" IRON with CAST IRON MON. AT Grd. SURFACE.

SEE pg 60

8-18-06
AKP ESL FOUND CIM & SHOT W/GPS.

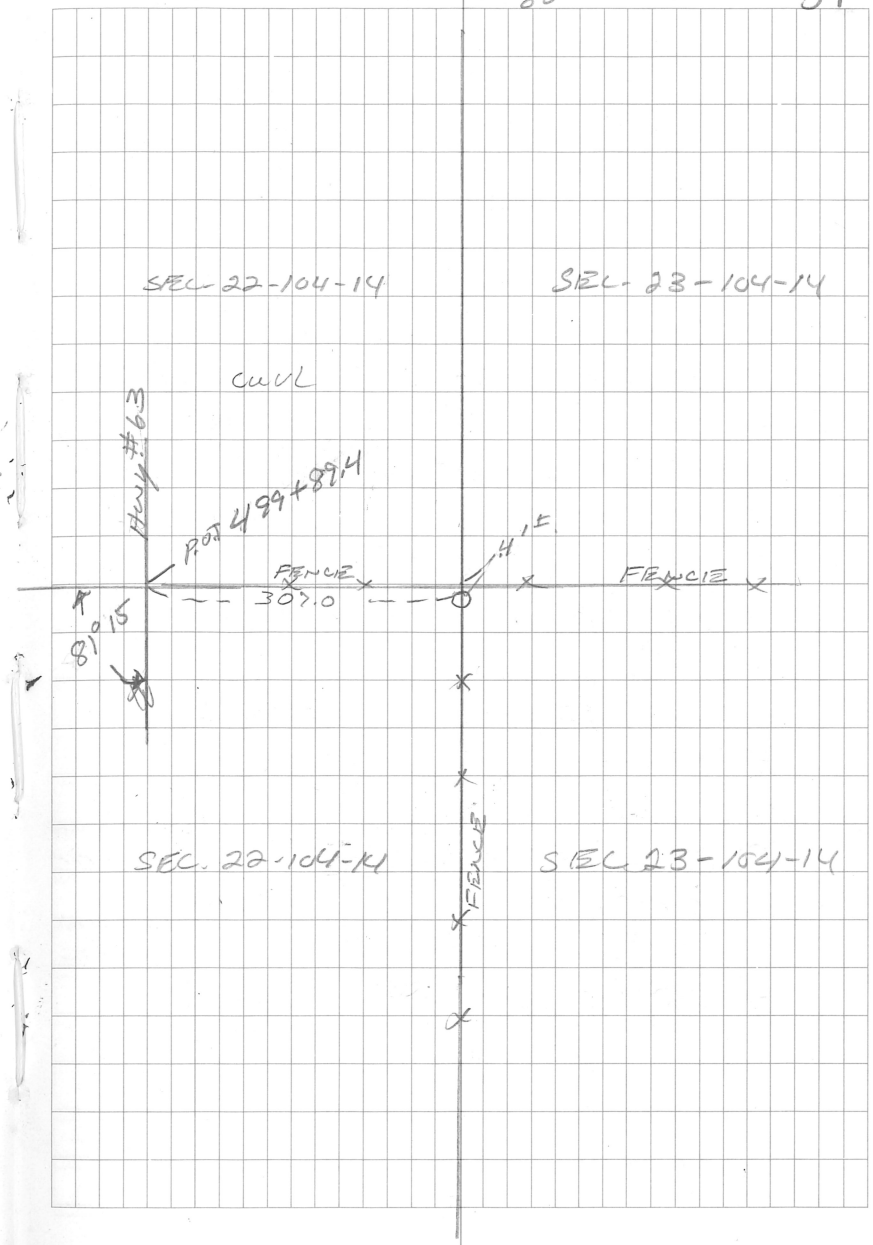

E¼ cor SEC. 22 - 104 - 14

SE cor SEC. 22 - 104 - 14

to Cp. (3)			P conc NAIL
BS Pt. (2)	℄ Hwy #63		
D	1626.03		
FS Pt. (3)	POT –		Fd conc mon Iron Pin
∠	04°46'03"	835.98	
FS Pt. (4)	℄ Hwy #63		
∠	126°25'54"	388.21	
FS Pt. (5)	℄ Hwy #63		
∠	168°52'30"	1984.95	
FS Pt. (6)			
∠	163°32'03"	3083.56	
~~FS Pt. 11~~			
∠			
FS Pt. (12)	POT. North		conc mon Iron Pin
∠	104°31'11"	876.10	
BS Pt. (13)	POT South		conc nail Iron Pin
∠	05°05'50"	794.24	

THS

7-13-04
County
800

THS
MHS

60

