
E 1/4 SEC 26-T104N-R14W

6/3/4 YAGGY COLBY & ASSOCIATES CREW FOUND A 3/4" IRON ROD FOUR TENTHS EAST & THREE TENTHS NORTH OF CORNER FENCE POST ON A TWO WAY FENCE INTERSECTION

SAT

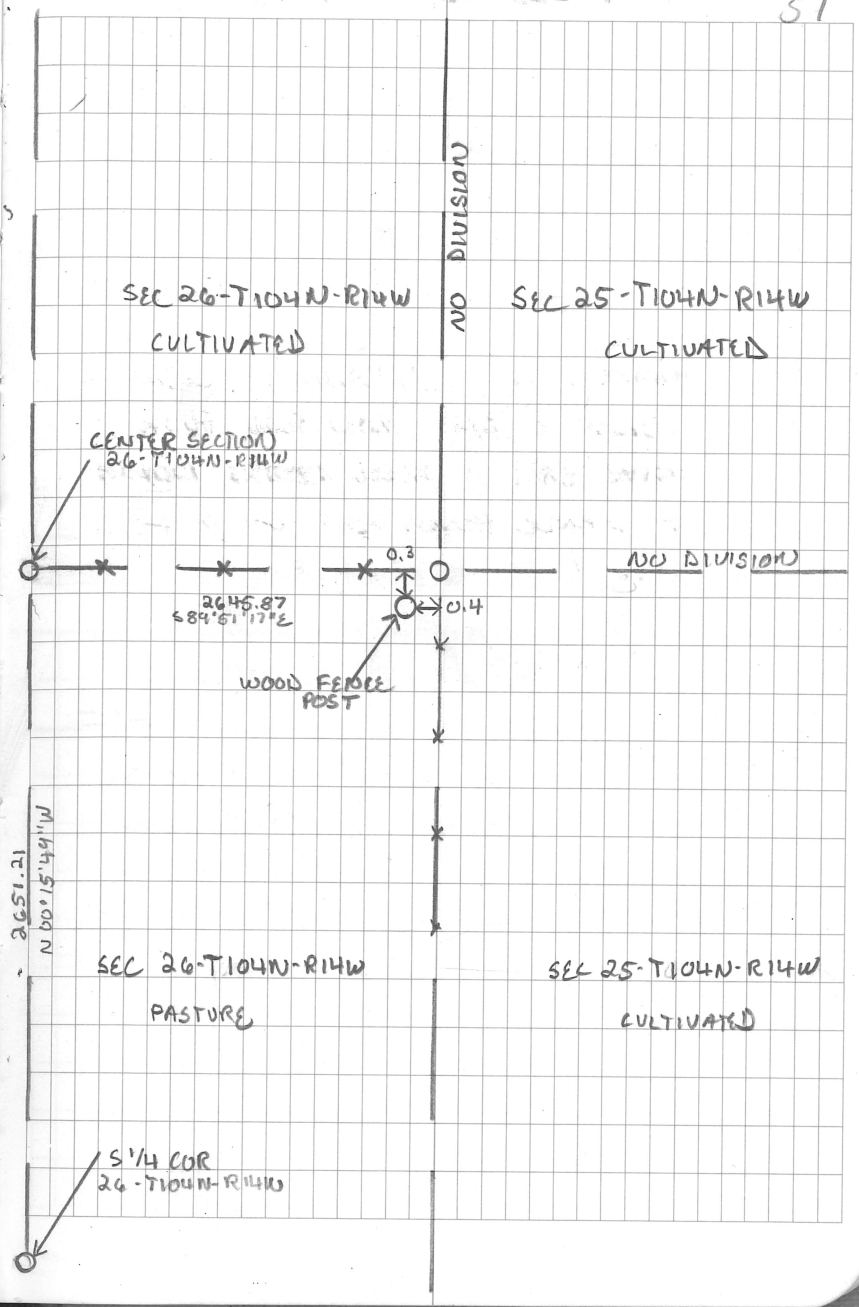

E¼ COR SEC. 26-104-14

NO INFORMATION FOUND
IN MOWER CO. RECORDS

THIS COR WAS ESTABLISHED
BY YAGGY COLBY ELEC &
L.S. IN JUNE 2006

