
E¼ COR. SEC. 33-104-14

5-2-03 CLEAR 600 HCS TCM

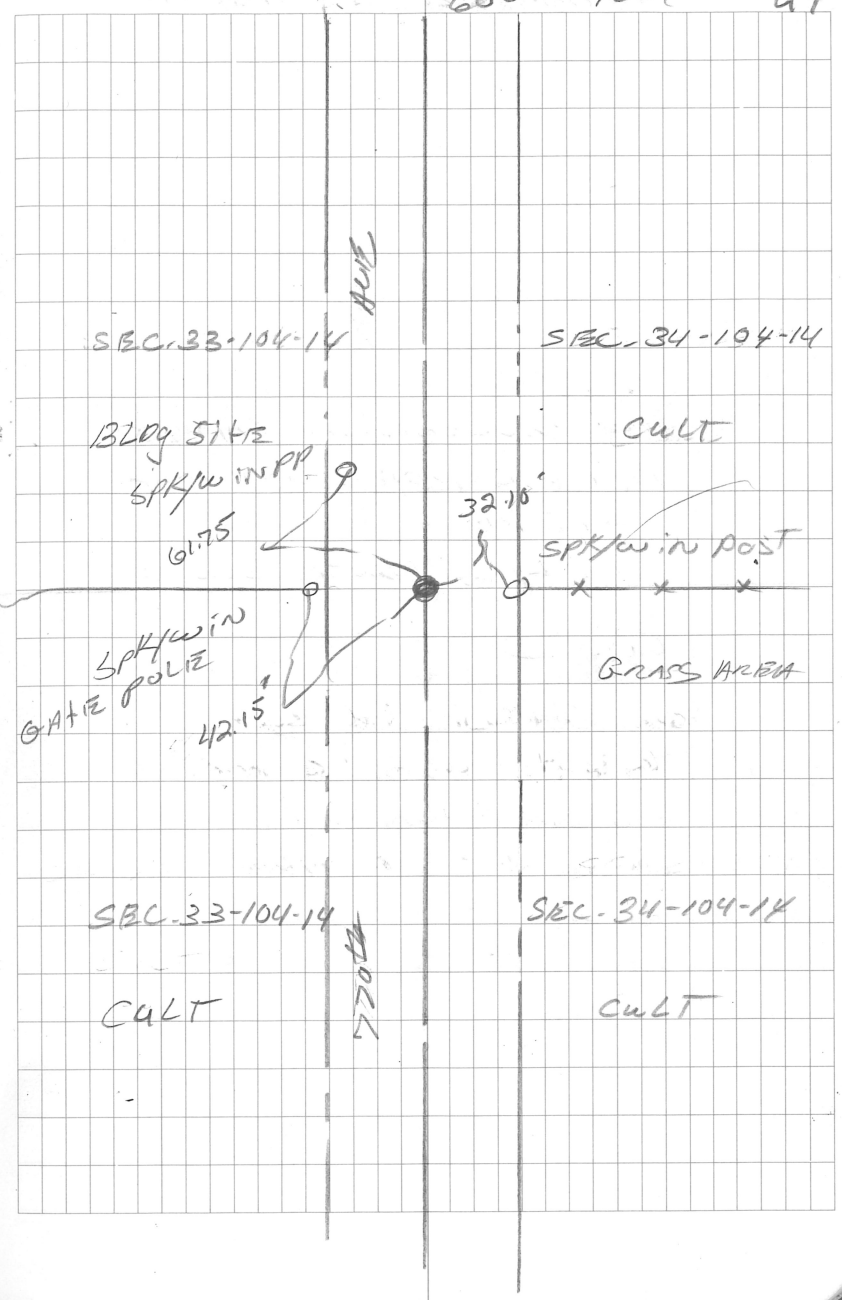

THIS CREW dug by HAND AND UNCOVERED CAPPED PIPE NO. 11009

FITS & ROAD & LINE FENCE EAST.

See Certificate from Zack.

11-6-81 Ronald Olson excavated @ location 3' north to 6' south of fence line East and 5' on both sides of ¼. No evidence of corner was found. Set ¾" pipe and cap @ intersection fence line East @ ¼

8-16-06 AKP EJL FOUND CAPPED ½" PIPE & SHOT W/GPS.