N1/4 Cor Sec 36-104-64


Corn. Filed 12-4-91 by JHS

Dug with Co. backhoe on ℄ E-W roads in line with fe. ~~east~~ north-south on straight line at midpoint between sec corners. Dug a 4'x12'x6' deep hole and found nothing set CIM @ midpoint on straight line

8-18-06
AKP ESL

FOUND CIM & SHOT W/GPS.

10-21-91 DRR 17.

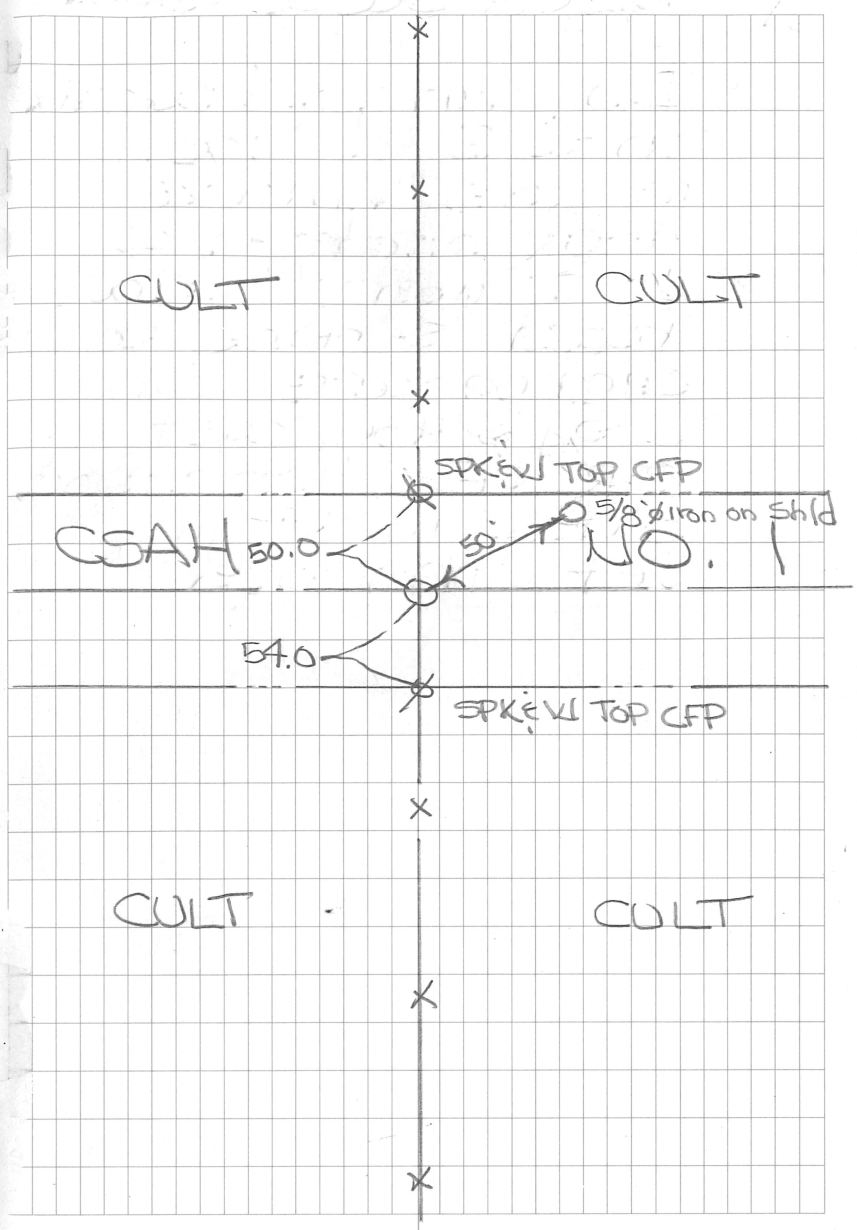

S 1/4 Cor - Sec 25 - 104 - 14
Bk 263, p 49

Placed conc. nail & w.
on line between SW & SE
sec. corners @ Midpoint
& E-W Rd., fe N-S

SW to SE Cor = 5319.43
1/2 = 2659.72' Midpoint

Vs. Co. grading Plan 5321.7

