
10-21-91 DRR 18

NE Cor Sec 36-104-14

cert. Filed 11-14-91 by JHS

Dug with Co. backhoe on ℄℄ at loc. of conc. nail & ⅄⅄ and uncovered a ½" T iron 1' below road surface. Cont digging and found a ¾" ⌀ iron cast in CTR OF 6" conc mon 3' deep in virgin soil set CIM over

8-16-06 AKP ESL FOUND CIM & SHOT W/GPS.

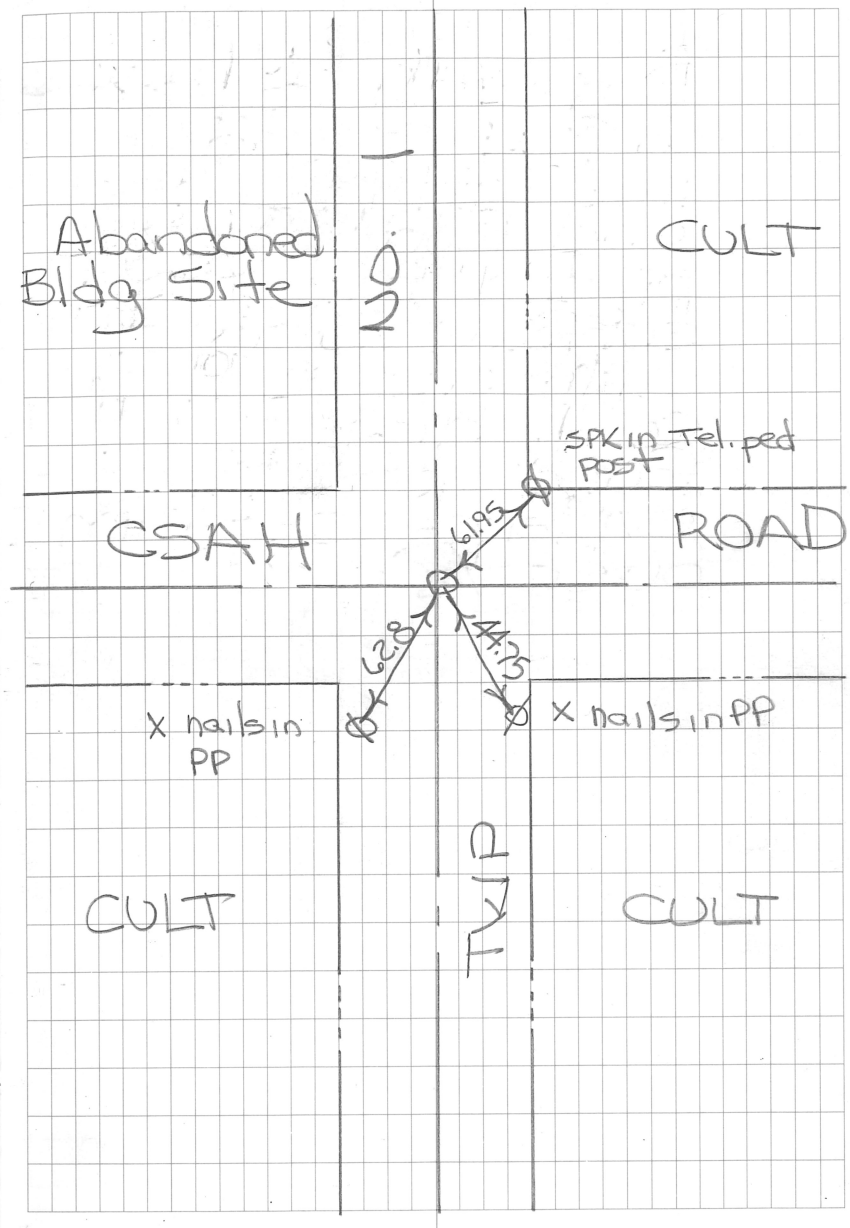


✓ by MLG

SE Cor - Sec. 25 - 104 - 14
Bk 263, p 50

Good dip; all ties check
℄ - ℄ N - S - E - W

X nails in PP SE 44.75
X nails in PP SSW 62.8
X nails in CFP SW 110.15


3-21-86 DRR
RMK

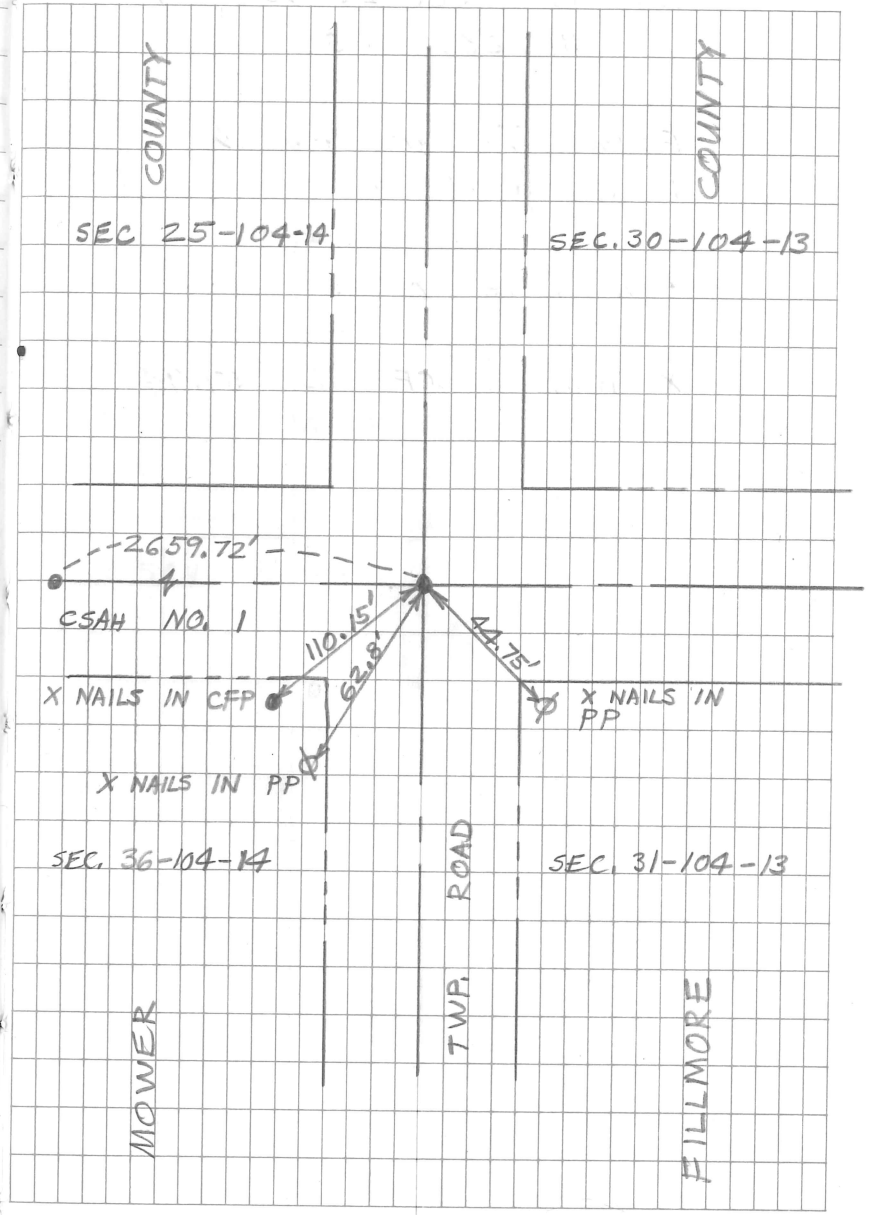

NE Cor Sec 36-104-14

Found conc. nail & VI flush in bitum. on C&C E-W-N-S roads ties from 1980 Filmore Co. corner cert. check left as found

3-11-91 DRR HLS

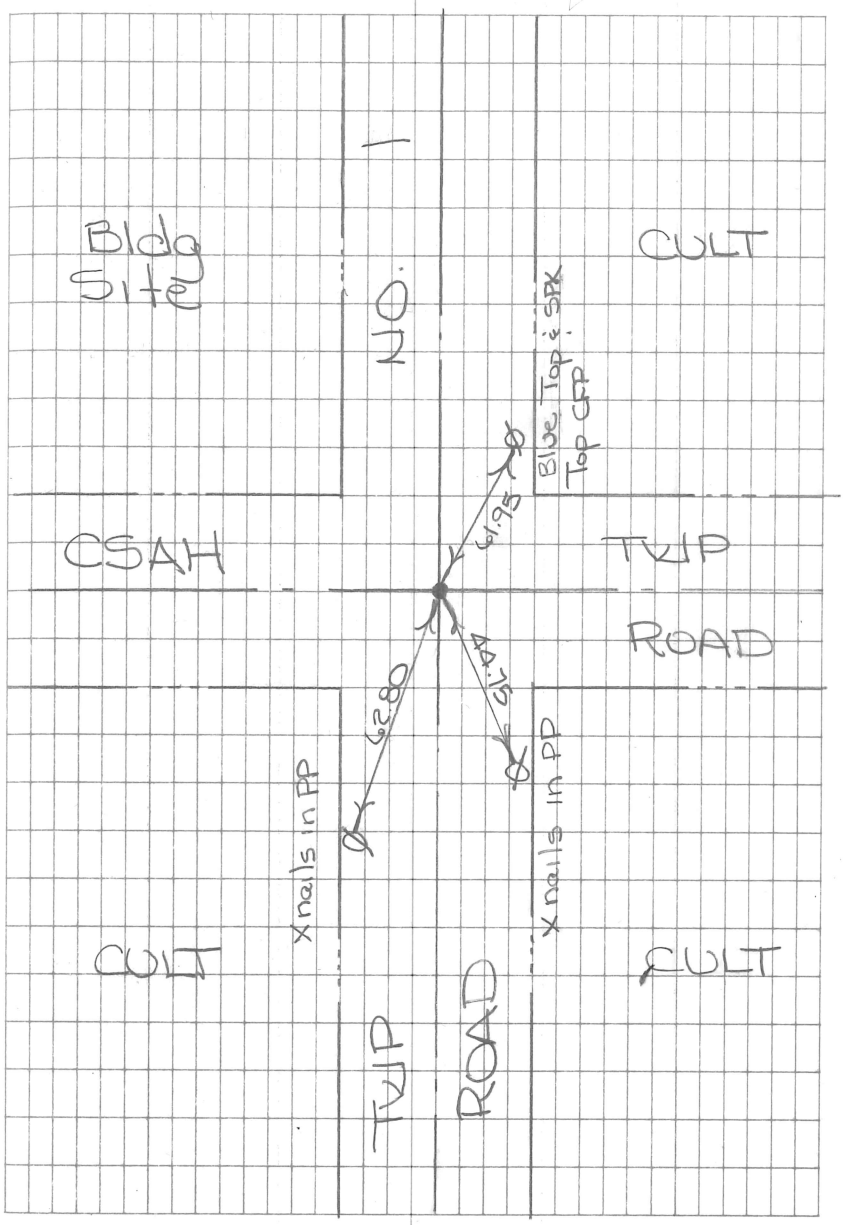

NE Cor Sec 36-104-14

Found conc. nail & WI flush in bitum. on ℄℄ of N-S-E-W roads all ties from 1980 Fillmore Co. corner cert. checked left as found

"NOTE"

10-21-91 REVISED - SEE pg. 18 (DRR)

3-11-91 DRR/HLS 1

