
10-17-91 DRR (72°) 5.

NW Cor Sec 19-104-14, 15

Found 5'x10' patch in bitum. W/ MN DOT CIM IN Patch stamped

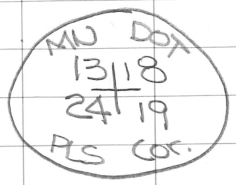

Left mon. inplace