NW COR SEC 31-104-14

Cert. Filed 5-25-93 by JHS

1945 BOOK 1 OF THE MOWER CO. HWY DEPT. NOTES A MON. IN PLACE.

NOTE: (2) ℄ P.I.'s @ location of Cor. 4.5' apart N.&S. ℄ P.I. found = ℄ CSAH #1 Vl. 9.0' S. of Sec Cor.


1993 JHS INC CREW DUG A 4'x3'x10' LONG HOLE 13.5' NORTH OF CSAH #8 P.I. AND IN LINE WITH ℄ CSAH #8 GOING SOUTH. FOUND NO EVIDENCE OF MON. NOTED IN MOWER CO. HWY DEPT RD PLANS. HOLE DUG WAS below depth OF VIRGIN SOIL. THEREFORE WE SET A CIM 13.5' NORTH OF CSAH #8 RD P.I. AND ON LINE WITH ℄ OF CSAH #8 GOING SOUTH ACCORDING TO SAID RD PLANS

"Note" ON 2-4-94 DRR HLS RESAT Cor. 4.5' South AND Retied Cor.

SEE BK. 384 pg 42.

5-25-93 FKS

CLEAR 70° 25'

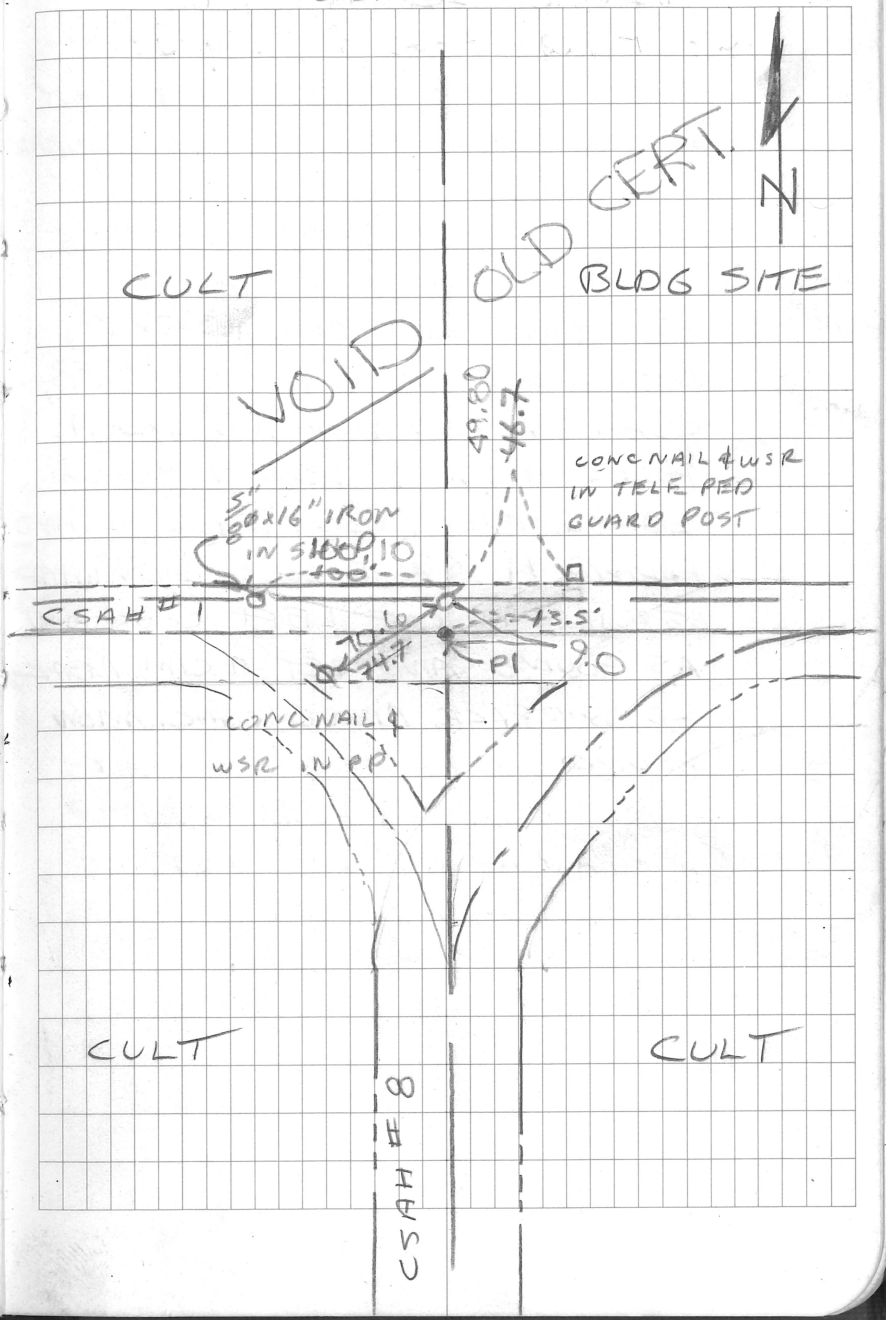

NW 31-104-14

See page 25

7-23-97 Reset & Reted

A 33.15
B 6.35
C 9.37
D 50.60

7-23-97
80°

HS 5
TRS



