S¼ COR SEC-10-104-16

SEE BOOK #1 pg 62


7-11-88 JHS CREW DUG WITH BACKHOE AND FOUND NO EVIDENCE of PLS CORNER

JHS CREW SET CORNER ON STRAIGHT LINE BETWEEN SE & SW CORNERS, AT SPLIT, CORNER FITS FIELD DIVISION N & S AND 2.0'± SO. of ℄ TWP ROAD. SET ⅝"ϕ X16" with CAST IRON MON, 60'± BELOW ROAD SURFACE.

8-10-01 PC JHS SAT

7.5°


55

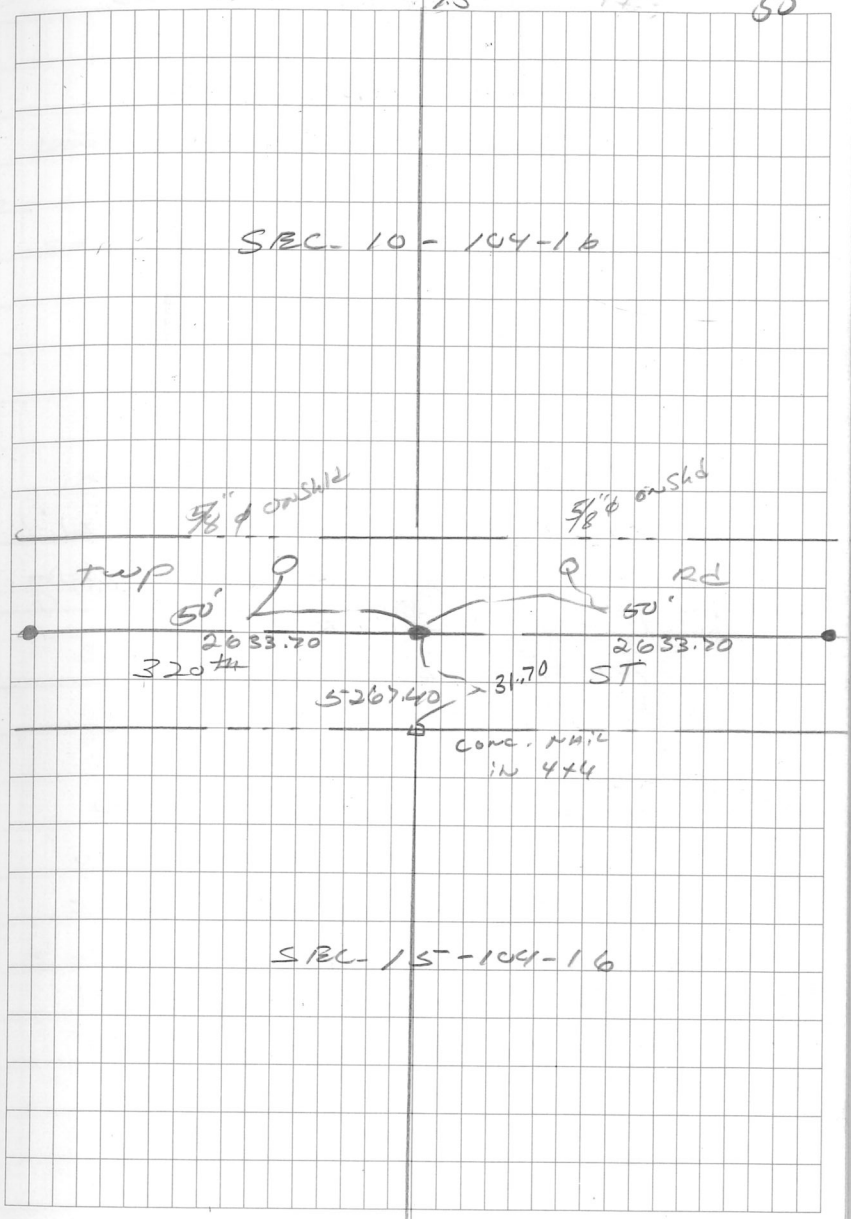

7-11-88 DRR 62

S1/4 Cor Sec 10-104-16

Dug with Co. backhoe on ℄ E-W roads in line with fld div. N-S and found no evidence of PLS Corner or a perpetuation of, did not set iron SW Sec Corner should be dug and corner shouldbe set on straight line at midpoint

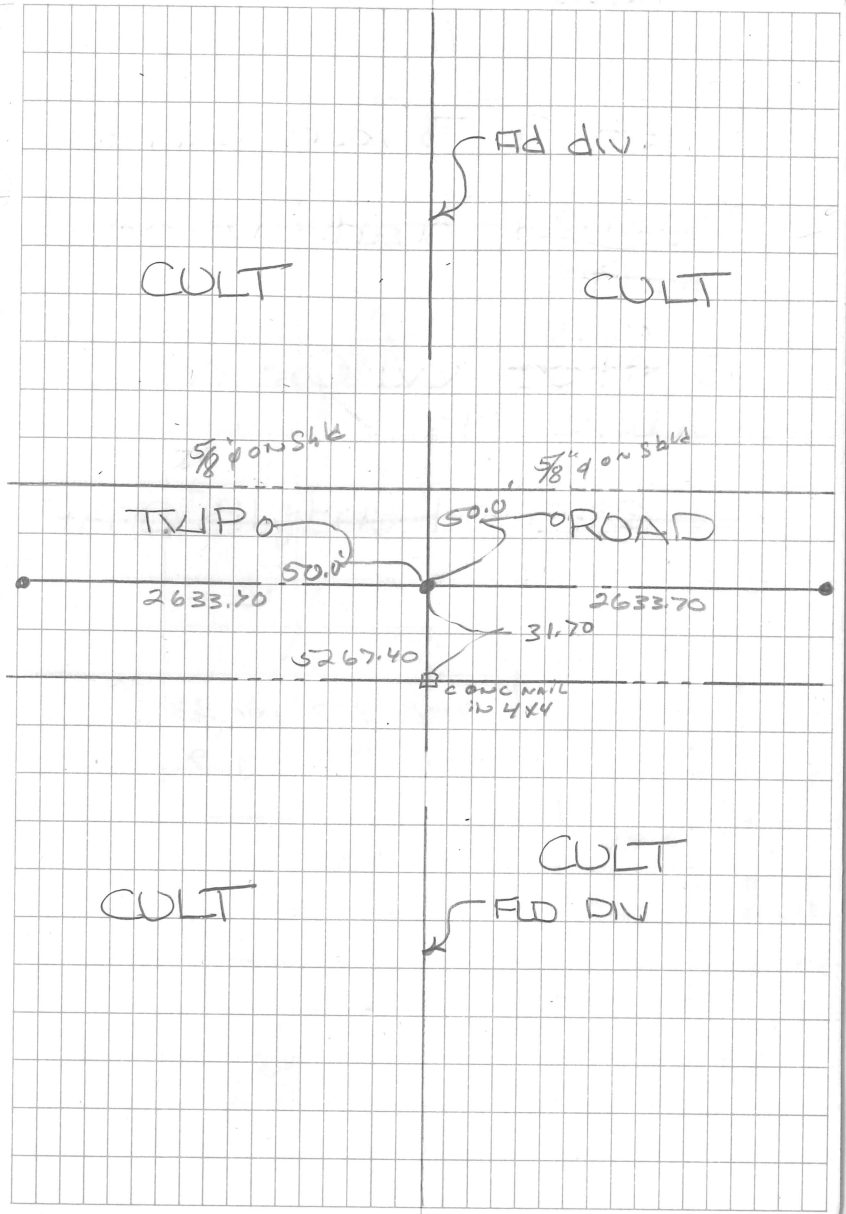

8-10-01 SEE SARGEANT TIE BOOK pg 55 Set corner