
SE cor SEC. 10 - 104-16

SEE BOOK-1 pg 59
for INFORMATION

SEE BOOK 315 pg 22

7-8-88
pc
+95°

JHS
JDP
TJF

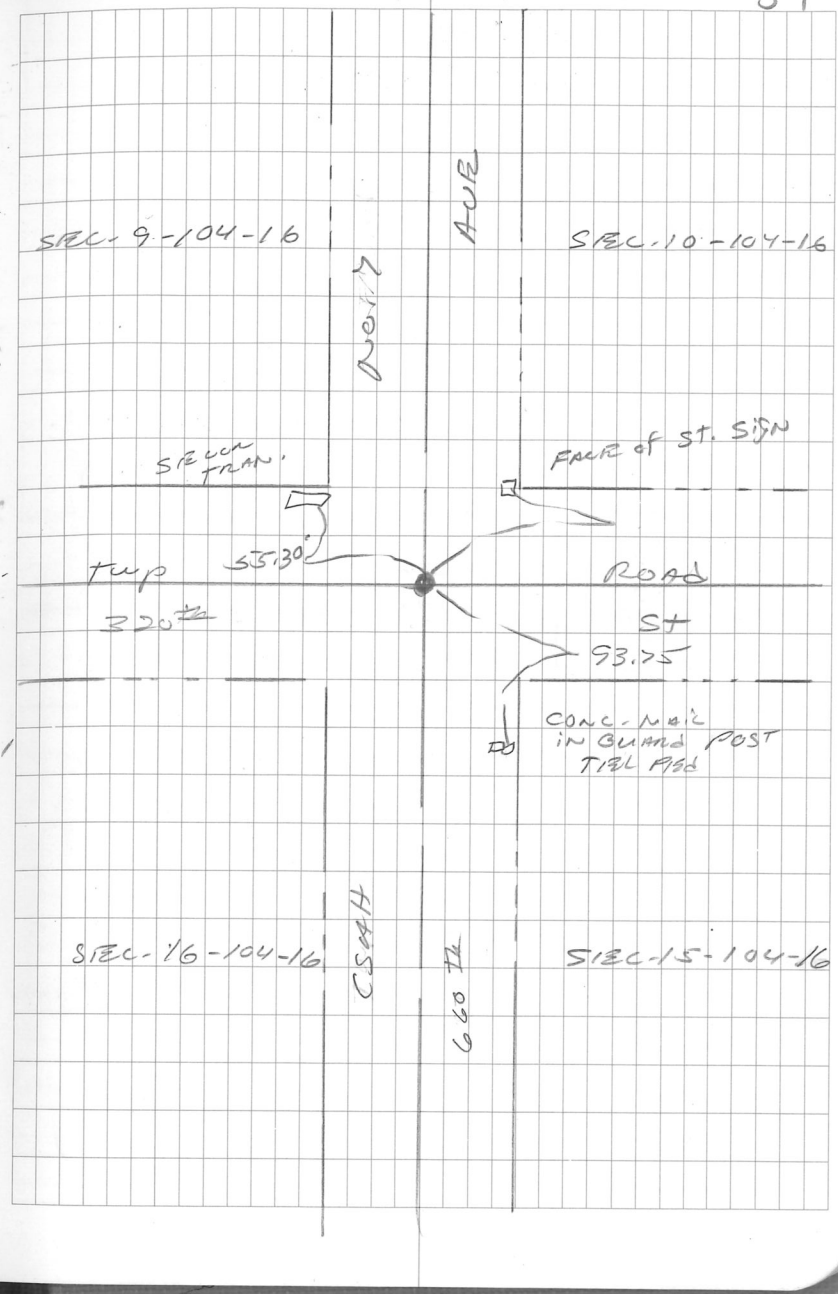

7-11-88 DRR 59

SE Cor Sec 10-104-16

Dug with Co. backhoe on CL of N-S-E-W roads and uncovered a wood stake over a 8"x12"x28" pointed Field stone 4" below road surface placed a 5/8"ϕ iron on east side of stone and a 5/8"ϕ iron over stone on road surface

Mon 1.75 So. & 1.10 West of JHS conc nail

HLS SHT

8-10-01 Tied corner.

