
SE cor SEC. 7-104-16

Mowitza Co. Record State

FNP 3" x 3" 30" Tkon

8/10/05 Fd Harrison Monument

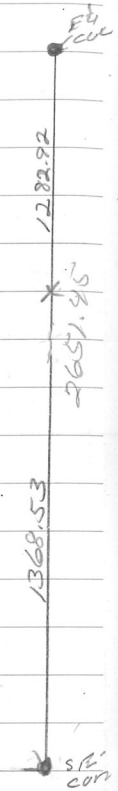

3-07-02
Cloudy

