
SW Cor Sec 29-104-16
cert. Filed 8-12-91 by JHS
Dug with Co. backhoe on ℄ ℄ and uncovered a 1" ø iron cast in the center of a 8" dia conc. mon. Above conc. mon found a broken harrison c1m reset c1m over conc. mon

7-18-91 DRR √6.

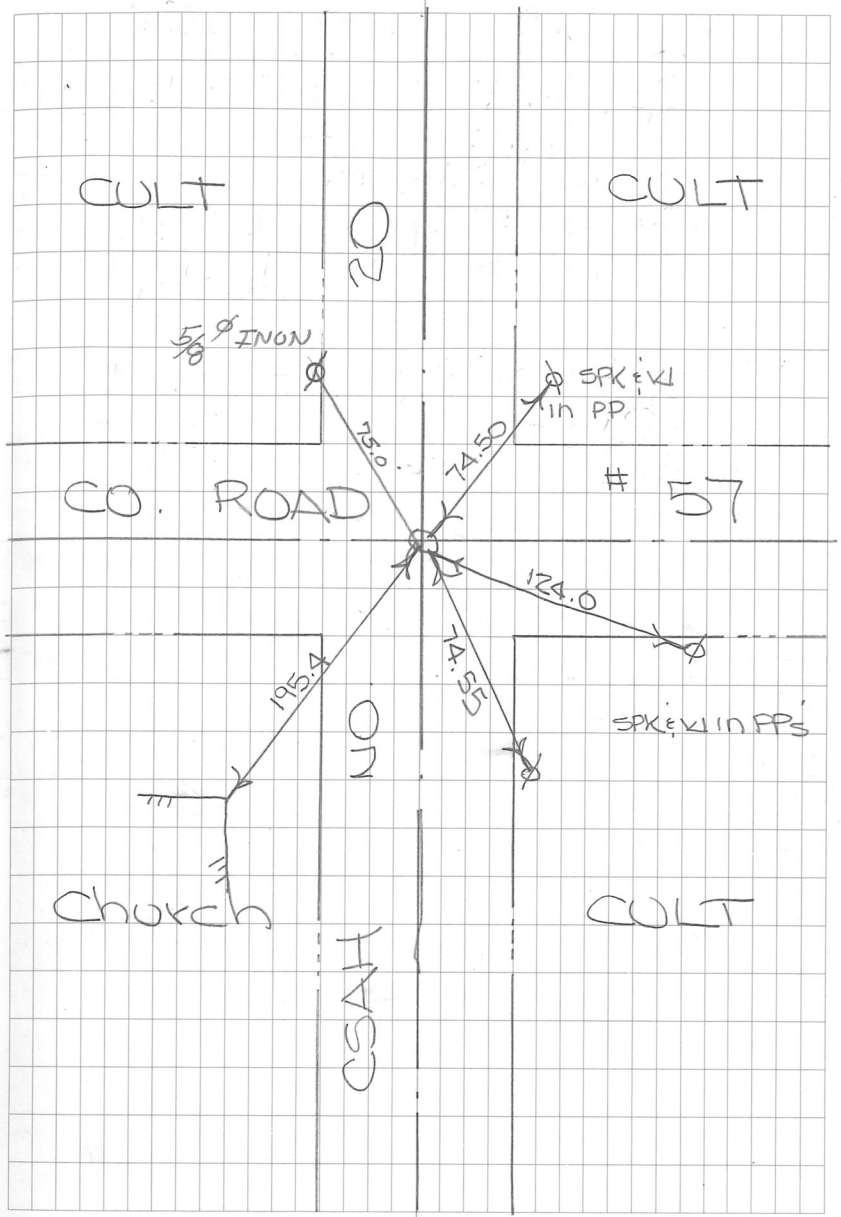

7-30-91 DRR/RMK 11
Clear 75°

CO. ROAD NO. 57
1991-92 Grading Project
see sketch in CS-file

0+00 = SW1 Cor Sec 29-104-16

℄ @ SW1 Cor Sec 29

BKST Radio Twr. E. of
Dexter Water Tower

S1/4 Cor Sec 29
∡ 318° 12' 25" 29"
D 2666.39

SE Cor Sec 29
∡ 318° 10' 43" 45"
D 5336.02



℄ @ SE Cor Sec 29
BK ST S1/4 Cor Sec 29

S1/4 Cor Sec 28
∡ 179° 58' 26" 30"
D 2635.53

℄ @ S1/4 Cor Sec 28
BK ST SE Cor Sec 29

SE Cor Sec 28
∡ 180° 07' 48" 45"
D 2665.36



℄ @ SW1 Cor Sec 27
BK ST S1/4 Cor Sec 28

S1/4 Cor Sec 27
∡ 179° 59' 16" 20"
D 2656.05

SE Cor Sec 27
∡ 179° 59' 18"
D 5312.10


















