
E¼ Cor SEC. 32-104-16

HHS CREW UNCOVERED ALUM MON @ this LOCATION.

9-7-90 ZENK ASSOCIATES SET CORNER

CORNER C/F

5-18-99 HHS
70° JPA
Cloudy

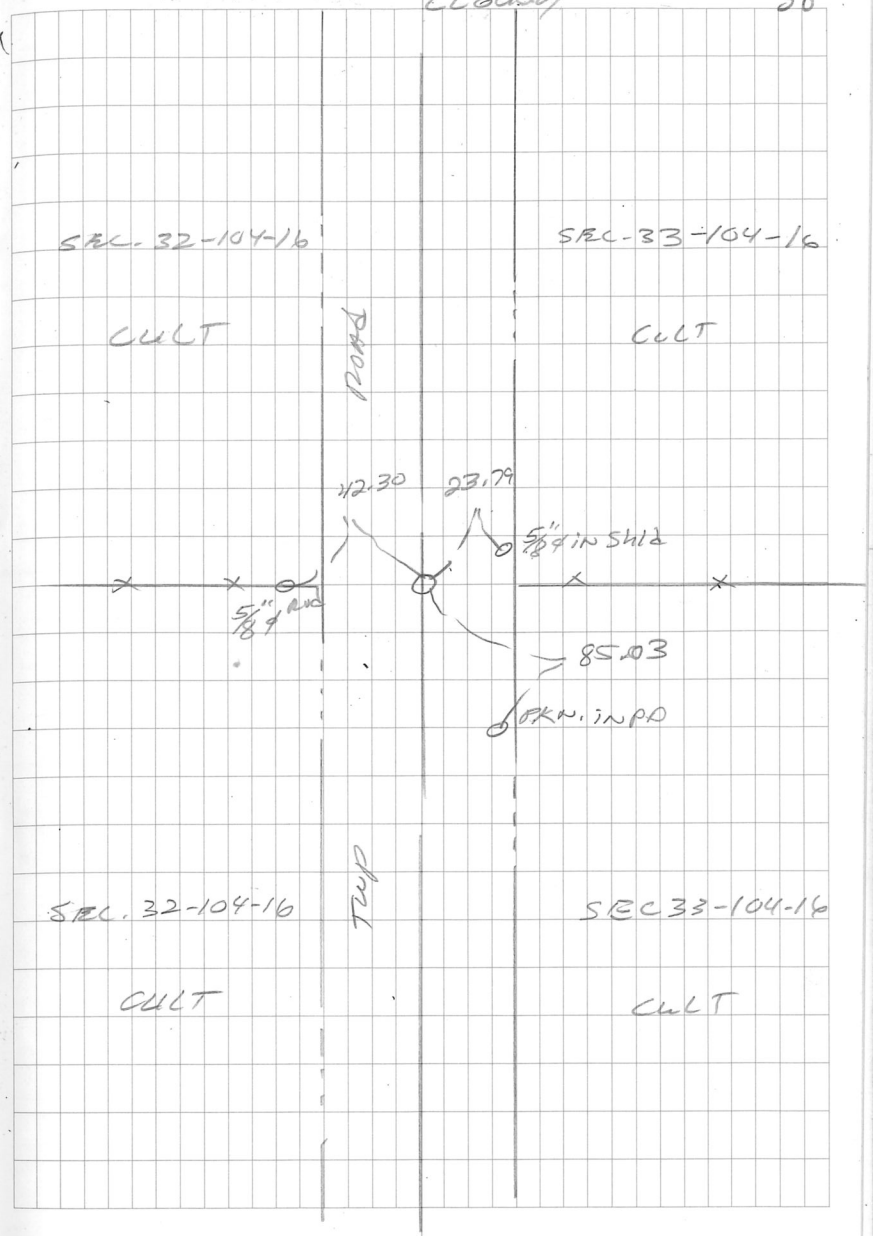

W/4 cor SEC. 33-104-16

THIS CREW UNCOVERED 5/8"ϕ
5/8"ϕ SET ON ℄ TWP Rd
ON 3-19-80 SURVEY
SEE BOOK 208 - pg 38

10-30-03 HLS
Cloudy 35° TCM

65

