W 1/4 COR SEC 1

7-21-05

MOWER CO HAS NO RECORD OF THIS COR

COMPUTED POS OF THIS COR ON STRAIGHT LINE BET SEC COR'S ∅ PROPORTIONAL PART DIST


8-1-05

Dug with Backhoe @ proportional part distance. Fd RR Spike .6' below road surface. 6'± west of ℄ Spike was 2'± south of propational part distance. Continued digging and Fd another RR Spike 1'± below top spike. Continued diggin and Fd no other evidence. Dug a 4'-10' hole.

Set 5/8" ∅ @ location of RR Spike

7-7-06

SET SPIKE & W AT PROPORTIONAL PART DISTANCE.

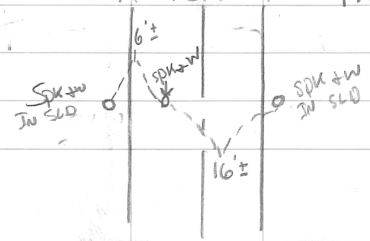

8-1-05 sunny 90

HLS EJH

23

