
NECOR SEC 2-104-17

corr cert filed 1-26-96 (JHS)

1993 JHS INC CREW DUG WITH CO. BACKHOE A 4'x12'x5' DEEPHOLE ON ℄℄ OF E-W & SOUTH RDS. FOUND A ¾" x 16" PIPE 0.30' DEEP., CAPPED RLS # 14888. CONT DIGGING TO A DEPTH OF 5' & FOUND A 12"ø x 20" LONG FLD STONE WITH A ¾"ø x 18" LONG ROD RESTING ON WEST SIDE OF STONE. Placed & capped 5/8" x 16" iron.

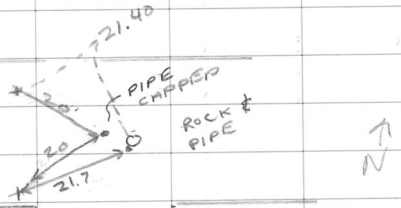

x 21.40

& 21.70

11-4-93
CLOUDY 50°

FKS
JJH

22

