SW cor SEC. 2-104-17

NO INFORMATION FOUND IN MOWER CO. COURTER RECORD

Dug with Ray Tucker BACKLINE on 4 N-S TWPRS AND IN LINE W/ TH LINE FENCES E & W.

UNCOVERED 1½" PIPE 1.0' LONG. CONTINUED DIGGING AND UNCOVERED FIELD STONE 2.0± BELOW PIPE FOUND. PLACED 5/8" ϕ CAP 13807 ON WEST SIDE of STONE


SET 5/8" X 16" IRON with CAST IRON MON. OVER IN PLACE of PIPE.

.60± BELOW ROAD SURFACE.

See Tie Book 1 Pg 55

5-16-05
Cloudy
60°
HLS
MHS

10

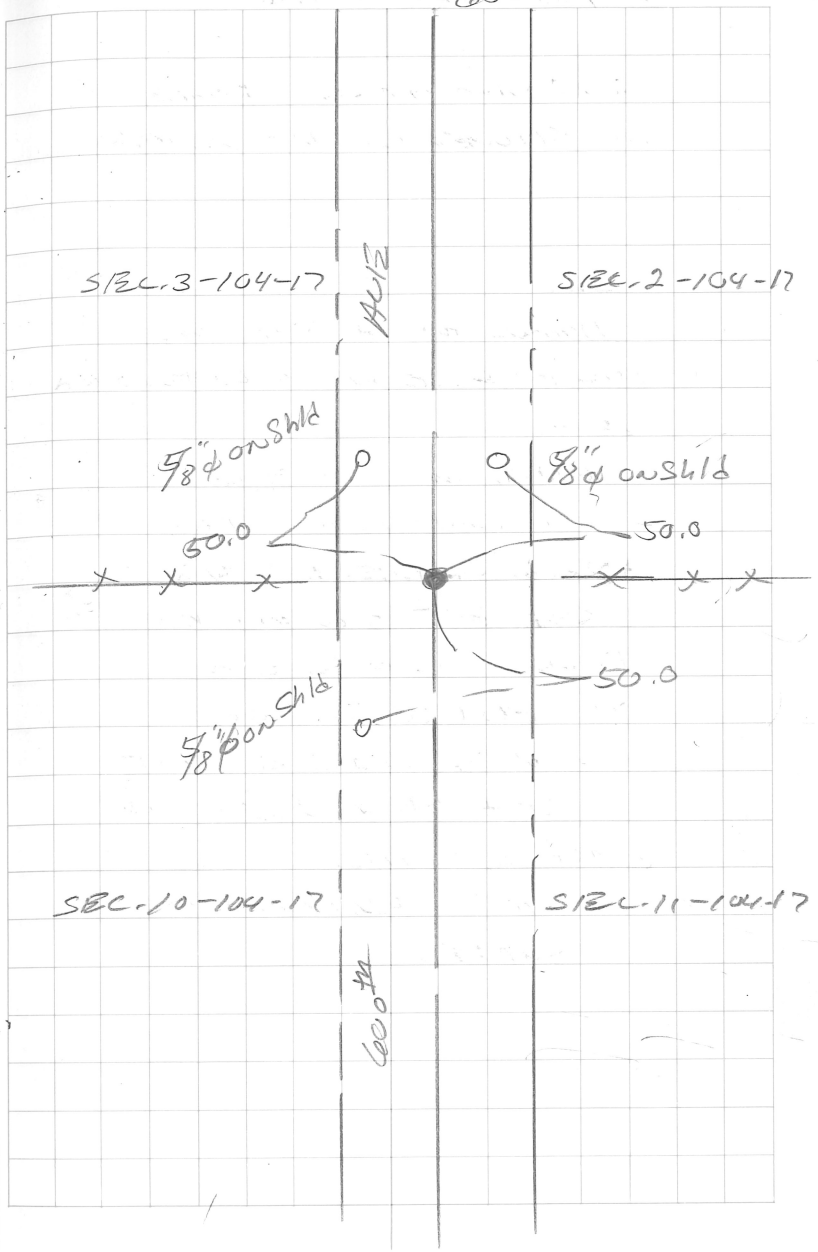

NE COR SEC 10-104-17

JHS CREW FD. CAP AXEL
AT E TWP. ROAD N-S
IN LINE W/ FENCE EAST
AND 4' SOUTH FENCE LINE
WEST. NO TIES SET.

* SHOULD DIG BEFORE
CERTIFING.

See Tie Book 2 pg 10

3-16-02
PC

JHS
TRS
SAT

