
N ¼ 16-104-17

REBAT by SJT 6-7-99 ±

5-26-96
50°
Cold & Windy

JHS 5
LCV

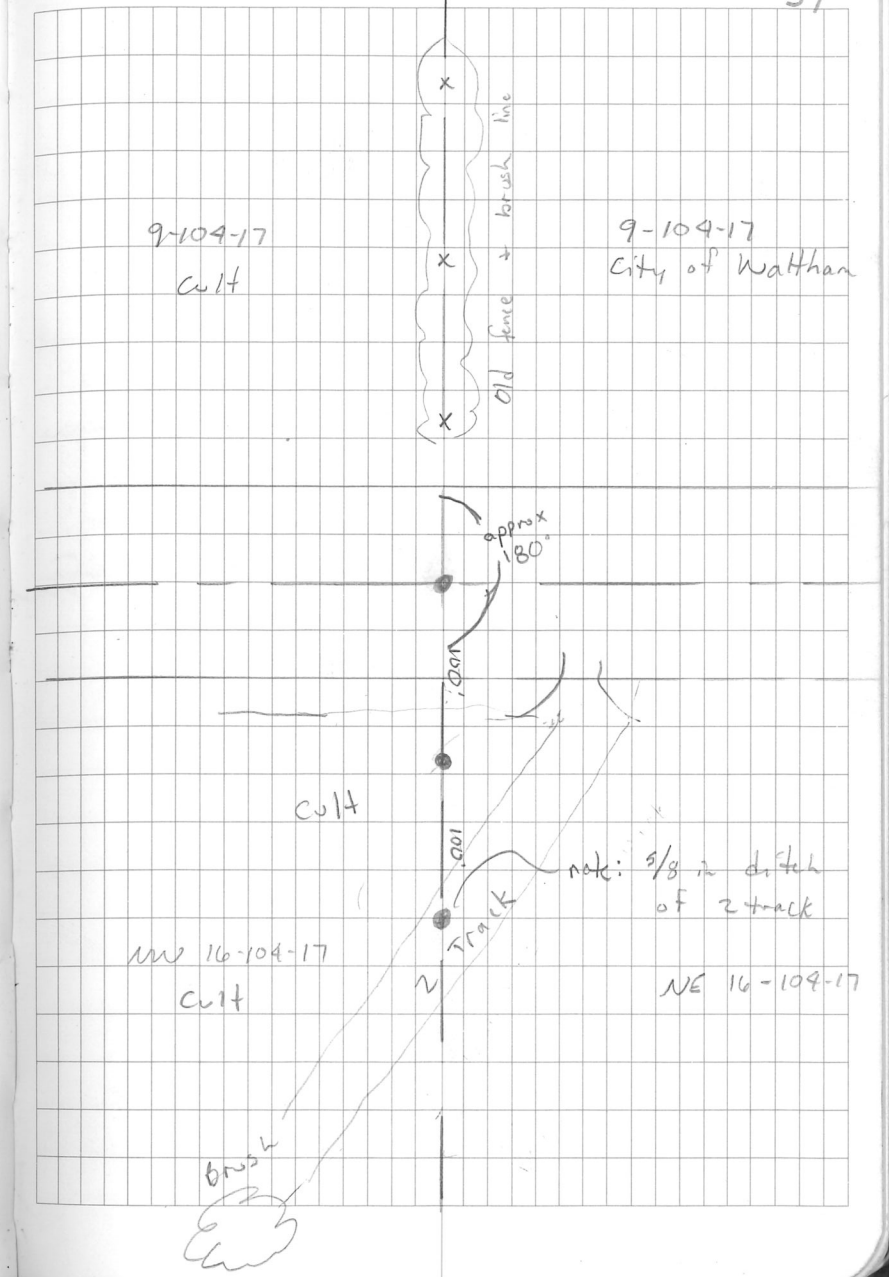

N 1/4 Sec. 16-104-17

Found ½"ø IRON IN CONC.
mon. 2.5'± deep ON ℄
E-W Rd in line with
Fence NORTH.
Concrete mon. was 2'
EAST of 3/4"ø×12" IRON
found on surface.

SPK & W in PP No. 48.8'
SPK & W in Tel. ped. guard
Post SE 61.0'
℄ ± old RR (abandoned) E 111.0'

9-25-89
Clear 70°
DRR
SLN
✓ 1

