
NW 16-104-17

6-7-99 RESET - RETIED

5-27-96
50°
Cold & Windy

SHS 5
LCV

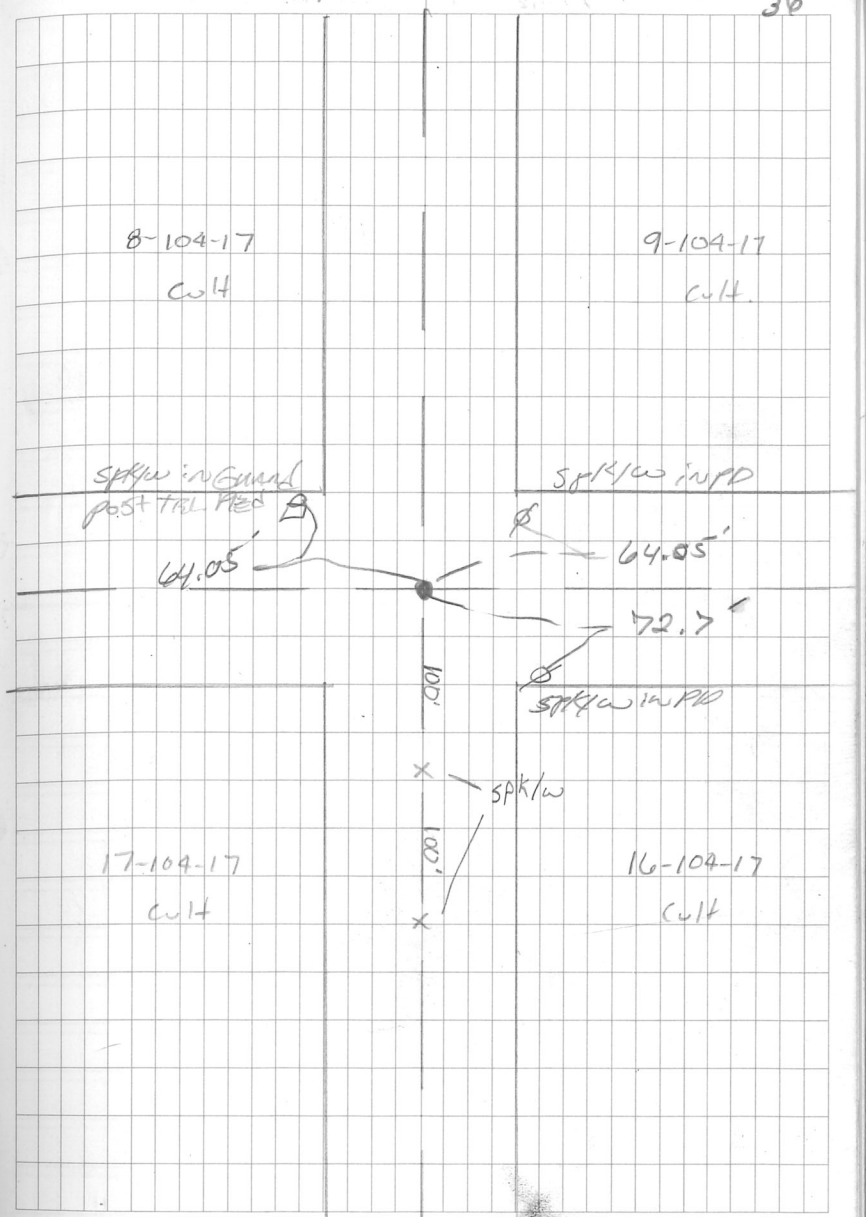

NW COR. Sec. 16-104-17

FOUND ½" ∅ IRON IN 6" round conc. mon. 3' deep on ℄ ℄. PLACED CAPPED 5/8" ∅ IRON over mon.

SPK & W in PP NE 62.2'
" " " SE 72.5'
" " Tel. ped. guard post SW 64.15

9-25-89 DRR
CLEAR 70° SLN ✓ 78

