5-19-05
Cloudy, >00


HLS
EJL

18

S¼ cor SEC. 24-104-17

No Information Found in Mower Co Corner Records

Dug with Ray Tuckier
Buckhorn on ℄ E-W Twp
Road and Twp Rd North.
Uncovered Large Rock
down 1.5'± with ½" Iron on
West side. Corner 2.5'± So.
℄ E-W Twp Rd.
Left Mon & Iron As
Found.
Set 5/8" x 16" Iron
with Cast Iron Mon. Outer
.60± Below Rd Surface.

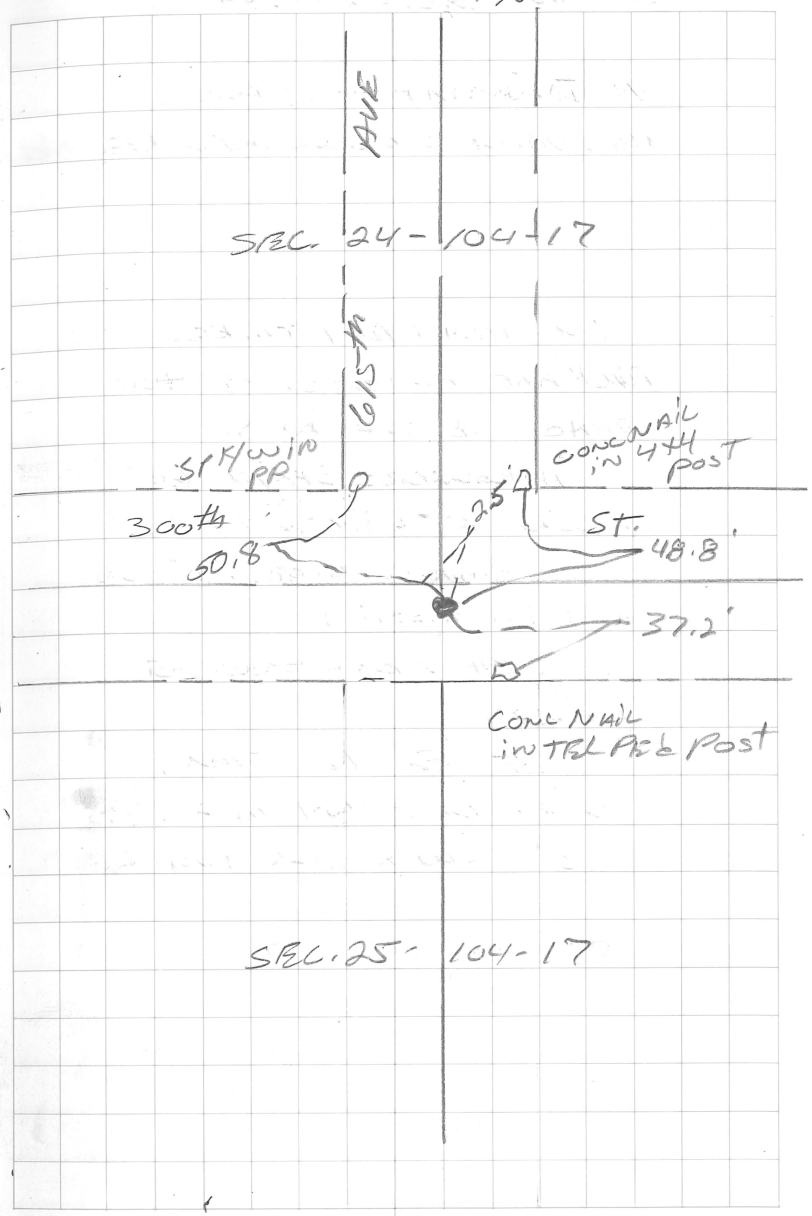

N¼ cor SEC 25 - 104 - 17

HLS CREW UNCOVERED A LARGE SPK 5'± EAST & TWP RD NORTH.

NEED to DIG

BOOK 2 pg 18

3-21-05
CLOUDY
35°

HLS
MHS
CPO

