
SW 7-104-17

6-7-99 JHS CREW LOCATED MONUMENT AND RETIED

JHS
TRS

5-27-96
cloudy & windy
50°

JHS 5
LCV

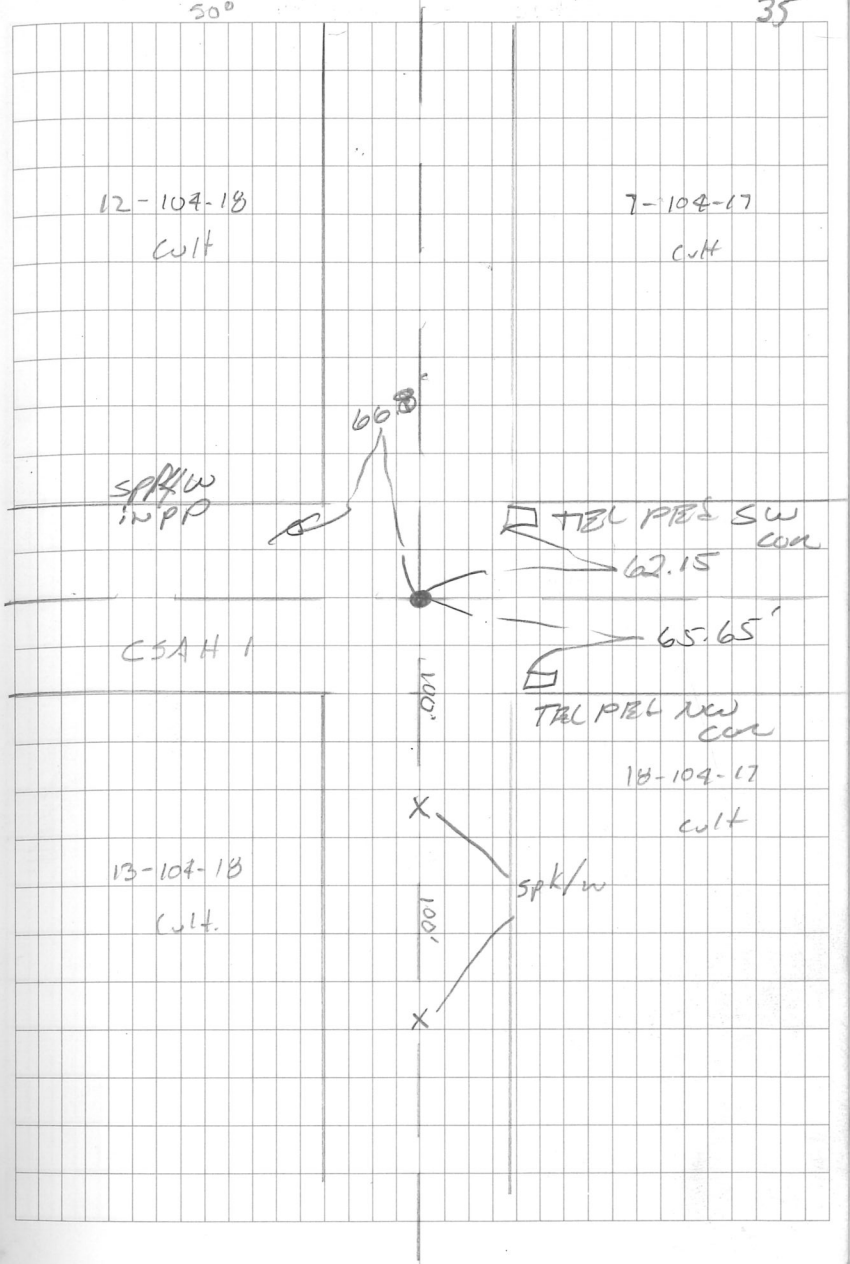

SW Cor Sec 7-104-17

Dug with Co. backhoe on ℄ an uncovered a 6" dia. conc. mon. with 1/2" iron 4' deep

Placed 5/8"Ø iron capped (13807) over monument found

nail 11 (S)

6-4-90 DRR SLN 18 ✓

