S¼ cor SEC. 24-104-18

NO INFORMATION FOUND
IN MOWER Co. RECORDS


SEE pg 60

TEMP COR.
JHS CREW SET SPK/W ON
℄ of TWP ROAD AND IN LINE
WITH LINE FENCE NORTH.

NEED to dig.
Dug with MOWER CO. BACKHOE
ON 9-25-03 - SEE pg 60

"NOTE" SEE BOOK 438 pg 5
SE cor to SW cor = 5301.80 ±
Gov. 5289.80

2-27-97
CLOUDY
30°
HLS
JPA

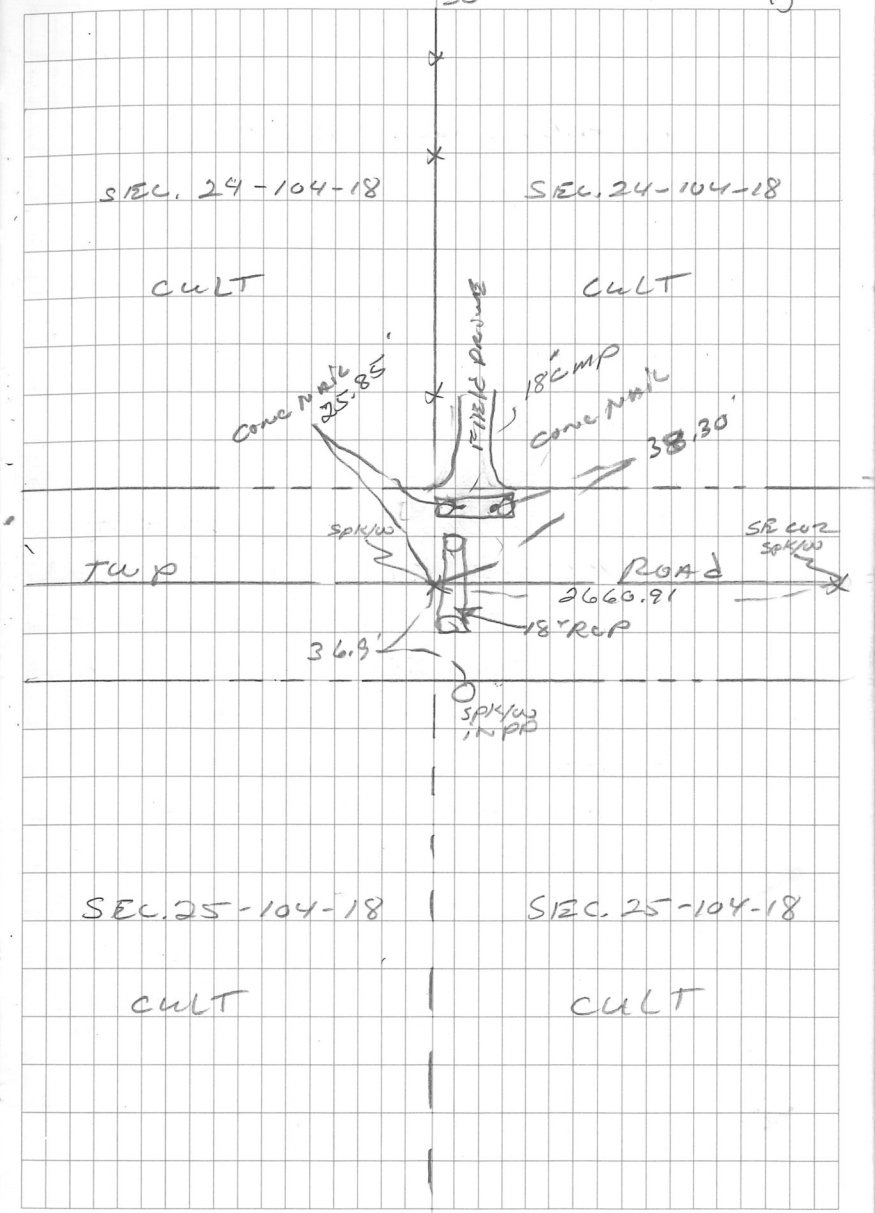

S¼ COR SEC 24-104-18

SIZE DIG 43

NO INFORMATION FOUND IN MOWER CO. CORNER RECORDS

DUG WITH MOWER CO. BACKHOE ON ℄ E-W TWP RD AND IN LINE WITH FIELD DIVISION NORTH.

UNCOVERED 18" RCP ACROSS ROAD, DUG ON BOTH SIDES OF PIPE AND FOUND NO EVIDENCE OF PLS CORNER.

SET CORNER ON ℄ E-W TWP RD AND IN LINE WITH FIELD DIVISION NORTH.

SET 5/8" x 16" IRON WITH CAST IRON MON.

60± BELOW RD. SURFACE

9-25-03
Cloudy
60°F

HLS
tcm

60

