

W 1/4 COR SEC 32

8-15-96 JAS CREW SET 5/8"-Ø IRON WITH CAST IRON HEAD W 4 WAY FELICE ILTER. SEE BK 430 p# 7

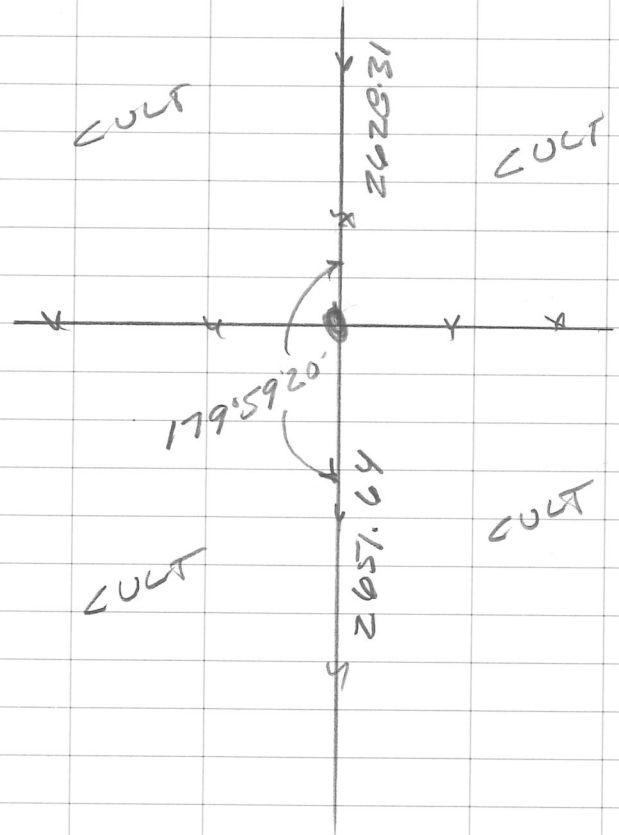

CURVE AND REDUCTION TABLES

Published by Eugene Dietzgen Co.

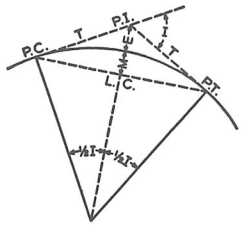

CURVE FORMULAS

1. Radius : $R=\frac{50}{\sin D/2}$
2. Degree of Curve: $D=100\frac{I}{L}$. Also, $\sin D/2=\frac{50}{R}$
3. Tangent : $T=R\tan \frac{1}{2} I$. Also, $T=\frac{T \text{ for } 1° \text{ curve}}{D}+C.$
4. Length of Curve: $L=100\frac{I}{D}$
5. Long Chord : $L.C.=2R\sin \frac{1}{2} I.$
6. Middle Ordinate: $M=R(1-\cos \frac{1}{2} I)$
7. External : $E=\frac{R}{\cos \frac{1}{2} I}-R.$ Also, $E=T\tan \frac{1}{4} I.$

EXPLANATION AND USE OF TABLES

Given P.I. Sta. 83+40.7, I = 45° 20′ and D = 6°30′ find:

Stations—P. C. = P. I. − T. $T=\frac{T \text{ for } 1° \text{ Curve}}{D}+$ C. From Tables V and VI $T=\frac{2392.8}{6.5}+.197=368.32=3+68.32$. Sta. P. C. = 83+40.7−(3+68.32) = 79+72.38. P. T. = P. C. + L, and $L=100\frac{I}{D}=100\frac{45.33}{6.5}=697.38$ Therefore, P. T. = (79+72.38) + (6+97.38) = 86+69.76.

Offsets—Tangent offsets vary (approximately) directly with D and with the square of the distance. From Table III Tangent Offset for 100 feet = 5.669 feet. Distance = 80 − Sta. P. C. = 27.62. Hence offset $=5.66\times\left(\frac{27.62}{100}\right)^2=.432$ ft. Also, square of any distance, divided by twice the radius equals (approximately) the distance from tangent to curve. Thus $(27.62)^2\div(2\times881.95)=.432$ ft.

Deflections—Deflection angle = ½ D for 100 ft., ¼ D for 50 ft., etc. For "X" ft., Deflection Angle (in minutes) = .3 × X × D. For Sta. 80 of above curve Deflection Angle = .3 × 27.62 × 6.5 = 53.86′. Also Deflection Angle = dfl. for 1 ft. from Table III × X = 1.95 × 27.62 = 53.86′. For Sta. 181 Deflection Angle = $53.86'+\frac{6°\ 30'}{2}=4°\ 8.86'$.

Externals—From Table V for 1° curve, with central angle of 45° 20′, E = 479.6. Therefore, for 6° 30′ curve, $E=\frac{479.6}{6.5}+$ Correction from Table VI = 7.378 + .039 = 7.417.