
W¼ cor SEC. 3 – 101 – 14

to	POL
BS	SW cor SEC. 3
D	4416.91
FS	NW cor SEC. 3
∠	180°00'00"
D	815.24
FS	W¼ cor SEC 3
∠	00°00'00"
D	1775.04

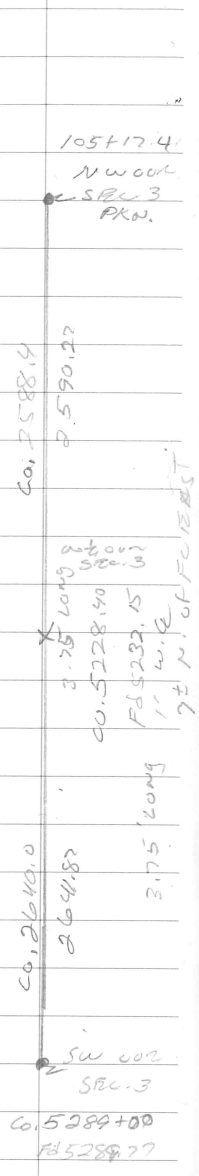

7-31-87
Cloudy
80°
HLS
AOM

21

