
N¼ cor SEC. 4 - 101 - 14
Cert. Filed 5-13-96 by JHS

NO RECORDS WERE FOUND ON S¼ COR. COR WAS SET at CORNER Post of LINE FENCE North & LINE FENCE WEST, DISTANCE being 5238.97, Govt. MEASUREMENT shows this to be with in 8'. NO EVIDENCE WAS FOUND USED CORNER Post AS BEST EVIDENCE,

10-14-94
Cloudy
70

HLS
JSR

(17)

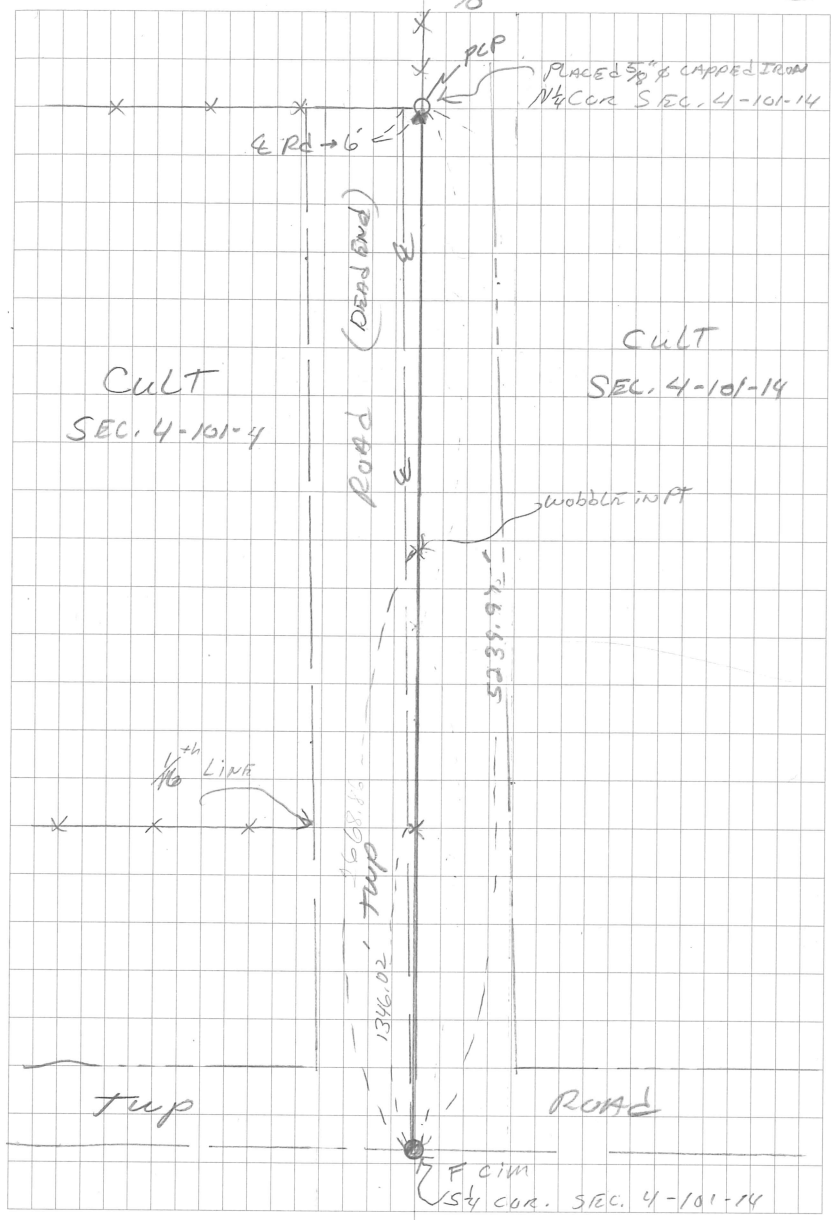

S1/4 COR SEC33

MONUMENT CO HAS NO RECORD OF A MON @ THIS COR.
3-6-06 - JHS CREW FOUND A CORNER FENCE POST @ THIS LOCATION & TIED IT IN WITH GPS.

