SE Cor SEC 33-102-14

Cert. Filed by JHS

MOWER CO. RECORDS SHOW AN

IN PLACE CONC. MONUMENT

DUG W/ MOWER CO. BACKHOE

A LOCATED A POINT ON

STONE, 5' BELOW ROAD

SURFACE. PLACED 5/8" REBAR

↑. AND PLACED A 5/8"

0.4' BELOW ROAD SURFACE.

5-11-04
CPV
EJL

Reset Monument after Regrading

Project using G.P.S.

Set a survey Pin @ this location.


S.6

10.9

5-16-06
70°
PC

TRS

46

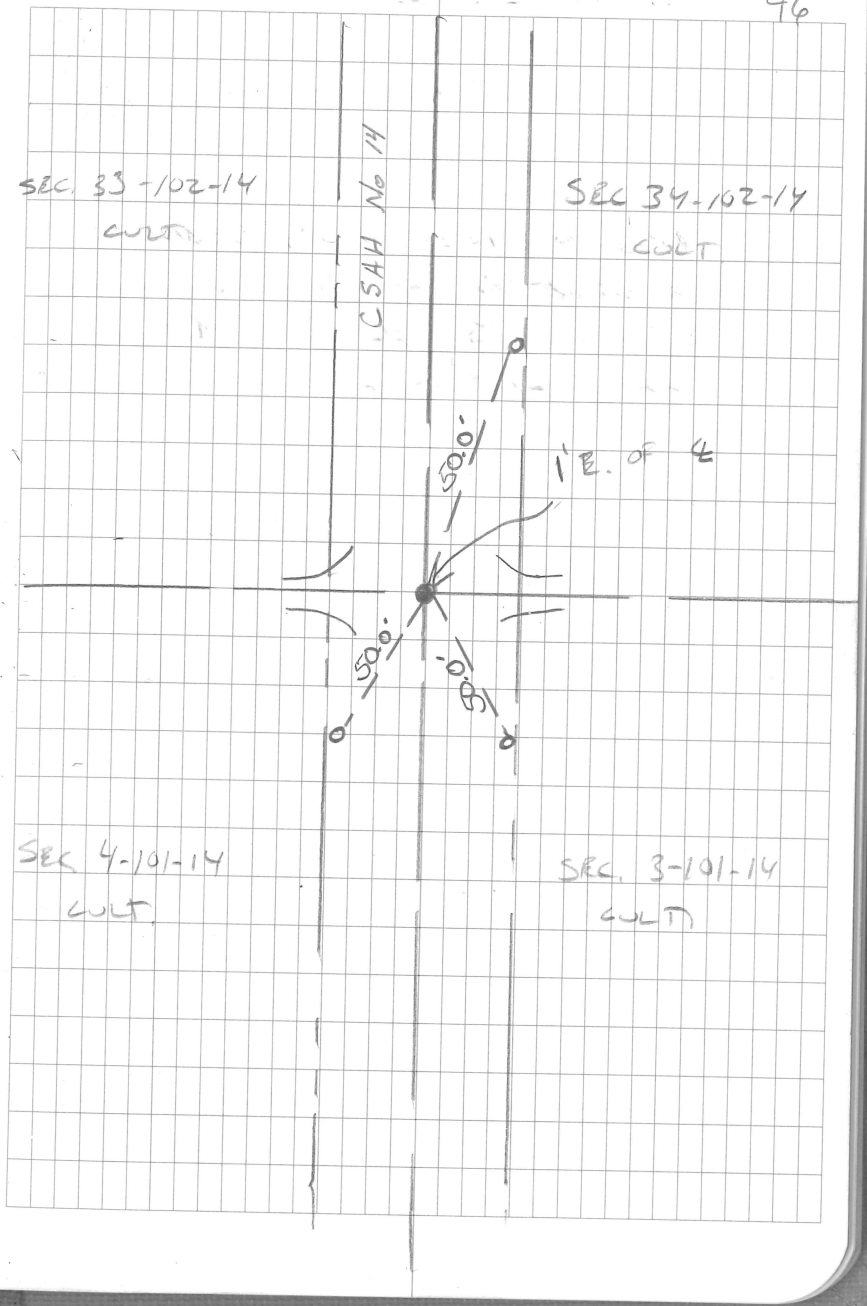

NW cor SEC. 3 - 10S-14

7-31-97
Cloudy
80°

ALS
ADM

22

