W¼ cor SEC. 10 - 101 - 14

TO POI

BS NW cor SEC 10

D 4224.36

FS SW cor SEC. 10


∠ 180°00'00"

D 1065.41

BS W¼ cor SEC. 10

∠ 00°00'00"

D 1574.97

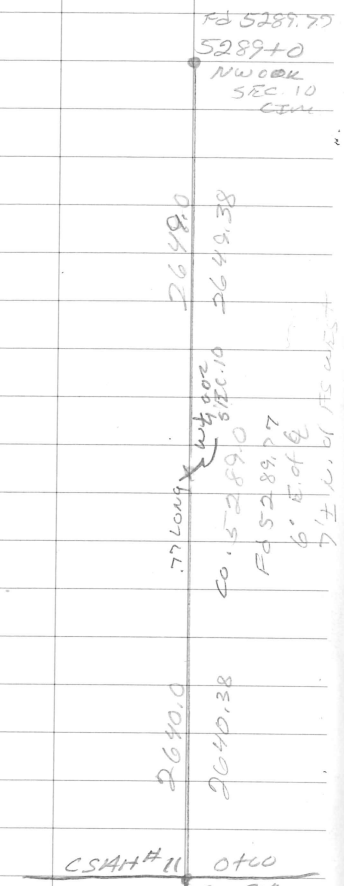

7-31-97
Cloudy
80°

HLS
ADM

20

