NW Cor Sec 15-101-14


Cert. Filed 5-16-91 by JHS

Dug on CC Co. Rds for overlay Project # CP 50-91-08-14

Dug a 6'x8'x4' deep hole and uncovered a 6" dia. conc. mon. in clay tile w/ 1/2" ϕ iron cast in CTR. cont. digging and uncovered (2) 3/8" ϕ x 12" irons over a 10"x18" pointed field stone with old wood post at 4 cardinal direction around stone, Placed 5/8" ϕ iron on north side of stone, reset Conc. mon. over stone and set CIM on road surface

Conc. mon. was 0.4'S & 0.4' W of pointed stone

5-7-91
PC 45° DRR/RMK 2

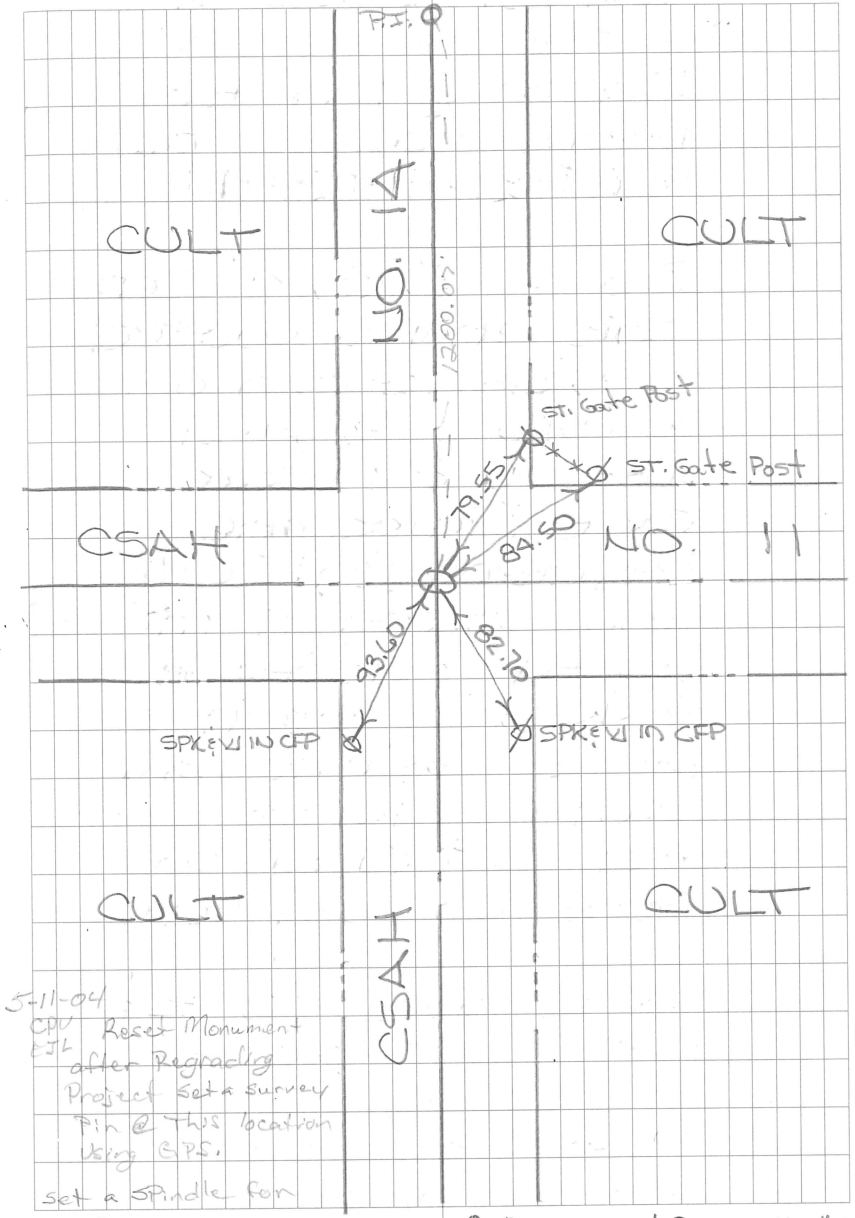

5-11-04
CPU Reset Monument
EJL after Regrading
Project Set a Survey
Pin @ This location
Using GPS.
Set a Spindle for
@ PI.

8-7-06 Found Survey MARKER
MHS SAT Shot With GPS