
12-12-96 SJT, ADM

18

S 1/4 cor Sec 22 - 101 - 14

Searched area w locator & probed by hand around fence corner. Found many stones Farmer said the fence corner has been used for 60+ yrs. accepted fence corner as marking orig location of PLS corner & set 22705 on S side of post.

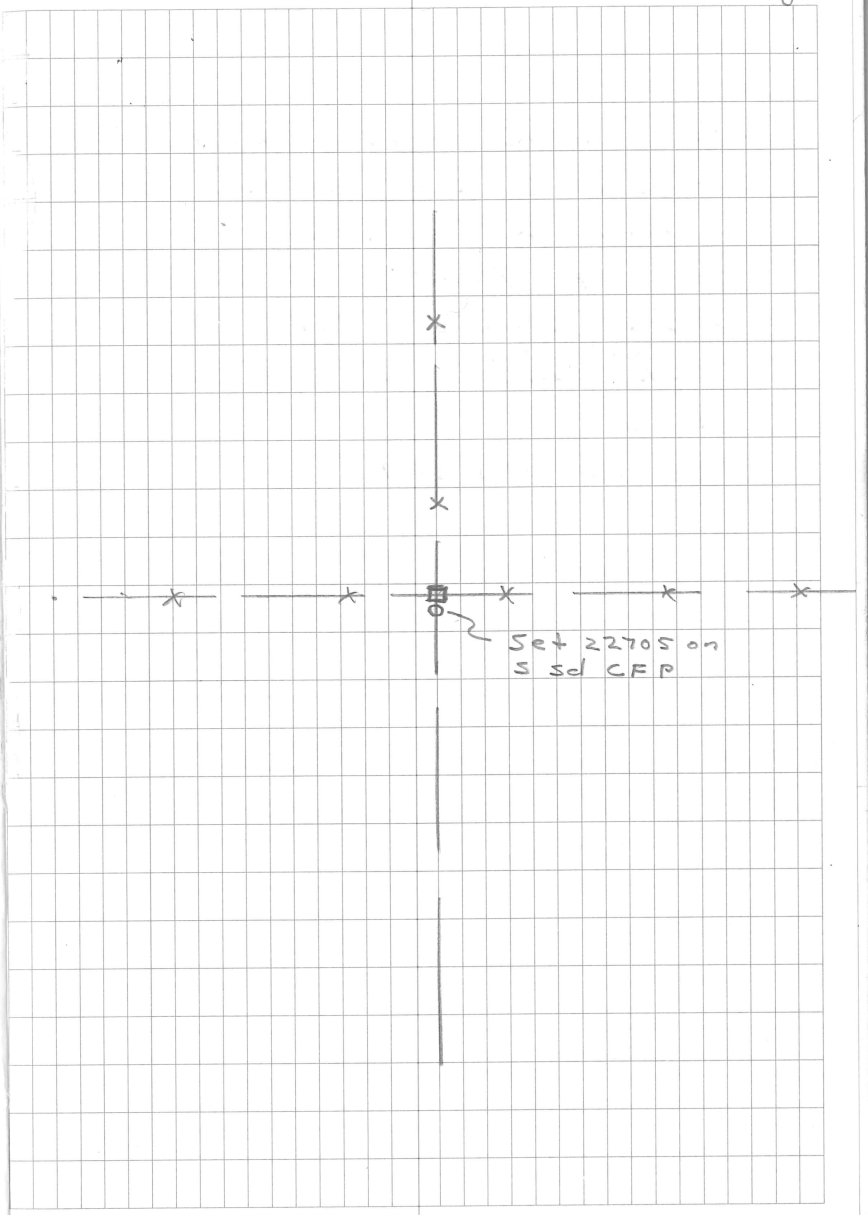

N 1/4 cor Sec 27-101-14

Searched area by hand & Found nothing. Accepted fence corner as marking pos. of orig PLS Corner.

3-20-01 SJT, CPV

